


UNITED STATES
DEPARTMENT OF THE INTERIOR
BUREAU OF LAND MANAGEMENT

SECTION 7
NE 1/4 NW 1/4

Oregon State Water Filings

TOWNSHIP 41-S, RANGE 24-E, W. M.

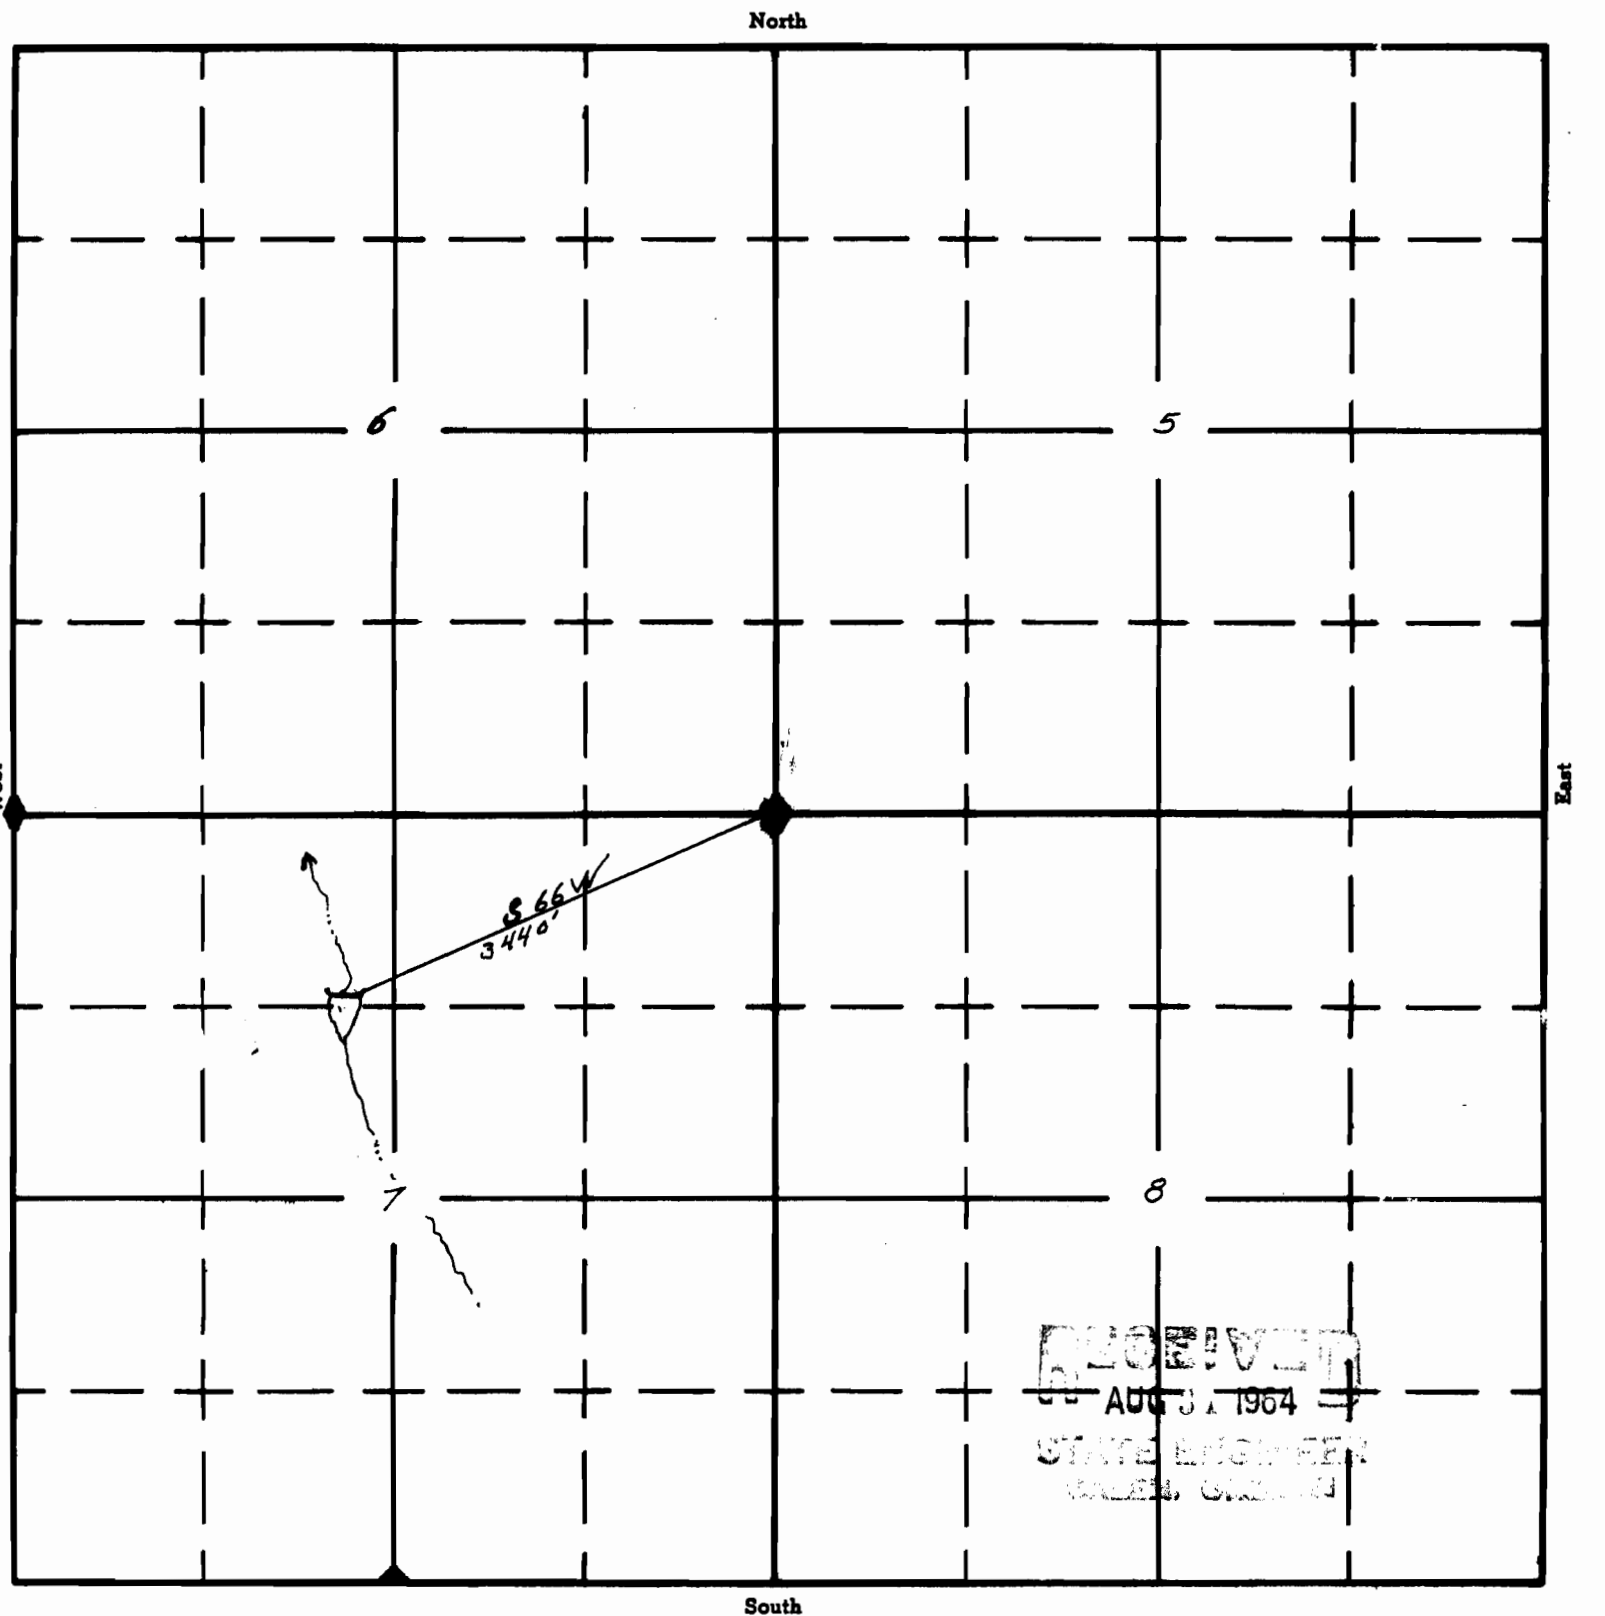

RECEIVED
AUG 31 1964
STATE ENGINEER
OREGON

May Lake 7 1/2' quad

APPLICATION No. R-40329
PERMIT No. R-4365