

DEPARTMENT OF THE INTERIOR
BUREAU OF LAND MANAGEMENT

17070 51414

SECTION

29


Oregon State Water Filings

RECEIVED

12 1/4 12 1/4

TOWNSHIP 34 S., RANGE 22 E., W. M.

TIED IN WITH AERIAL PHOTOS & O.S.H.D. QUAD MAPS

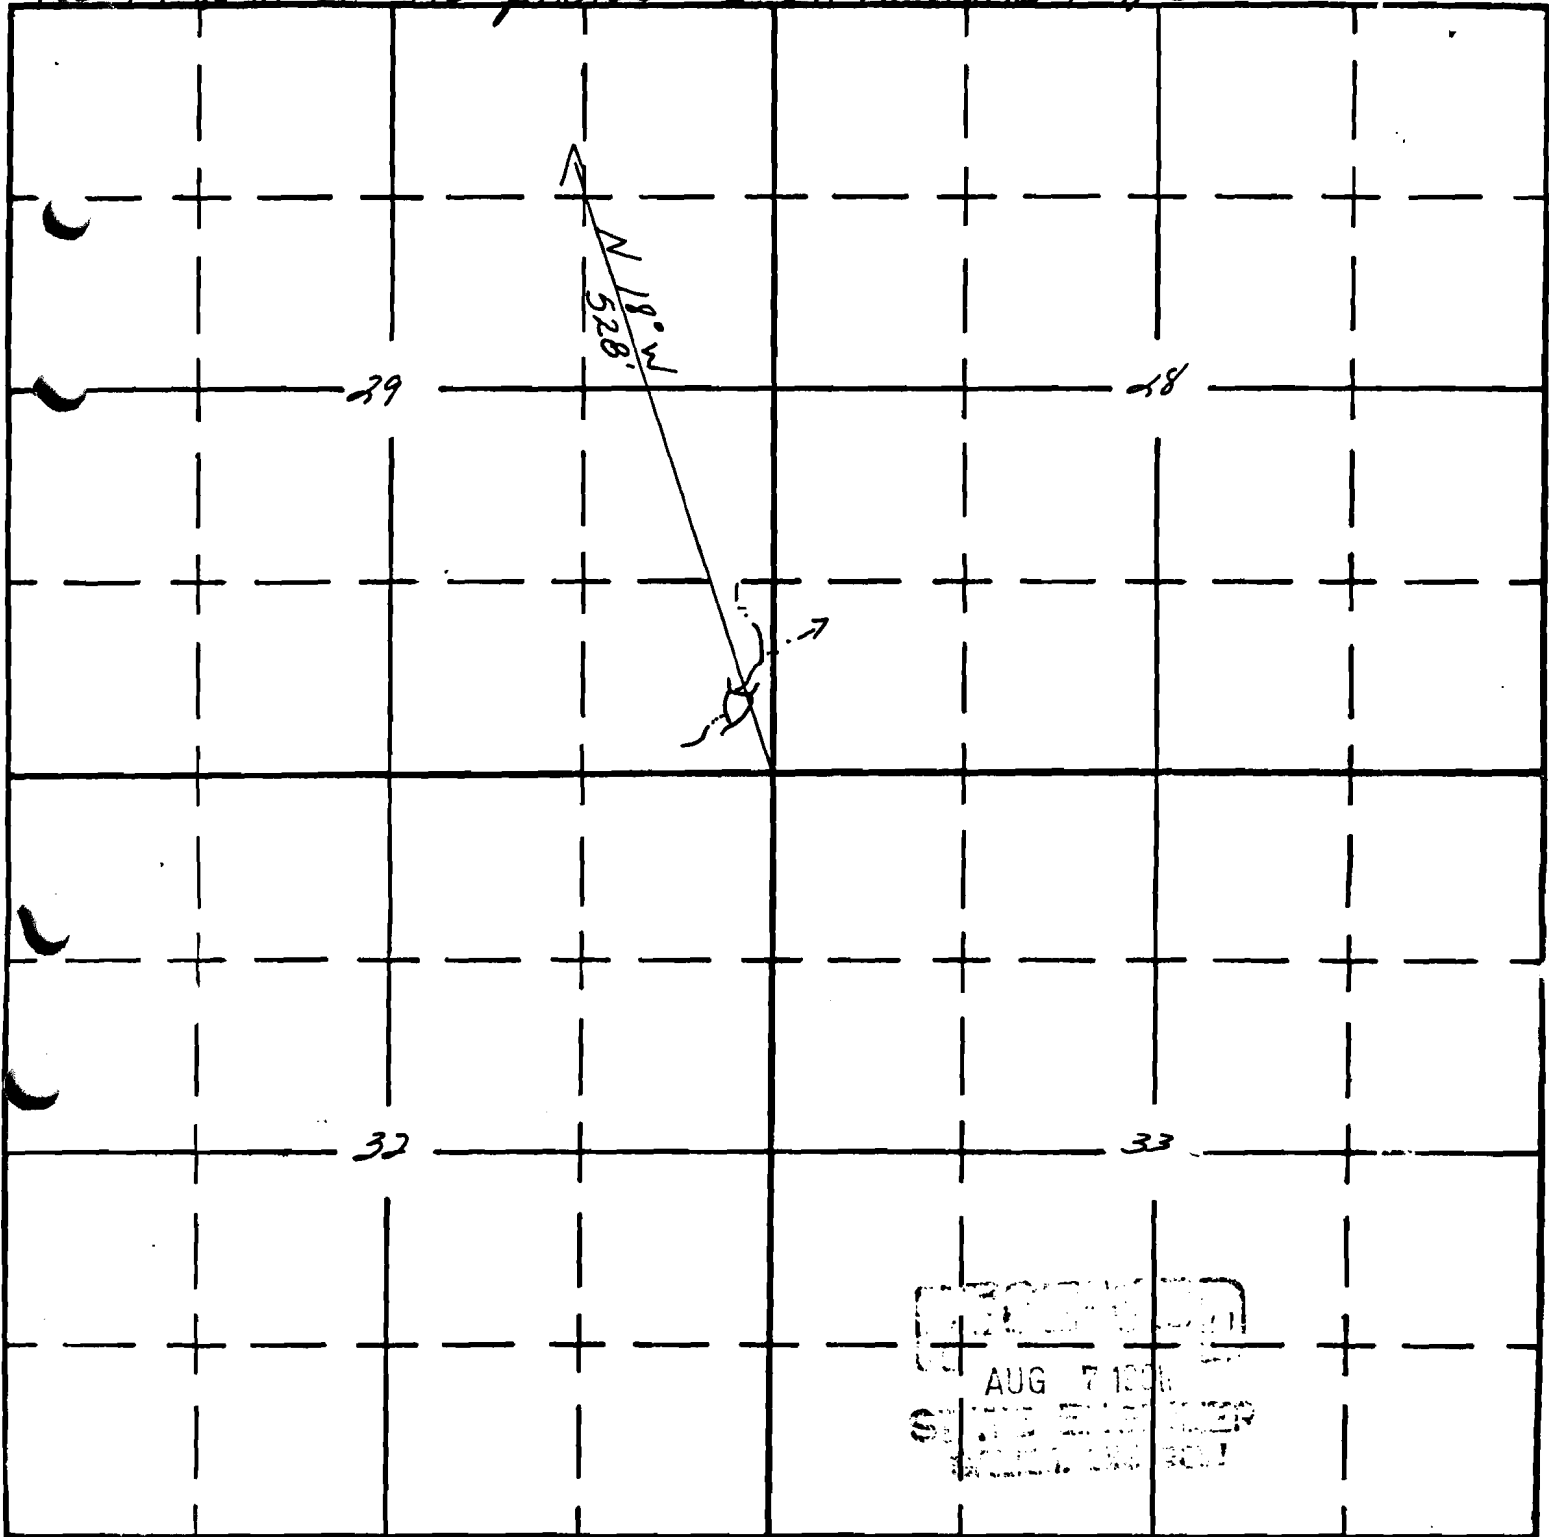

RECEIVED
AUG 7 1904
STATE ENGINEER
BUREAU OF LAND MANAGEMENT

South

Lake Abert South 7 1/2' quad

APPLICATION No. R-36223
PERMIT No. 7070