

Form AI-187
March 1961

UNITED STATES
DEPARTMENT OF THE INTERIOR
BUREAU OF LAND MANAGEMENT

R-7351
51418


SECTION

SE ¹/₄ NE ¹/₄
Sec. 27

Oregon State Water Filings

JAN 17 1963

TOWNSHIP 40-S, RANGE 26-E, W. M.

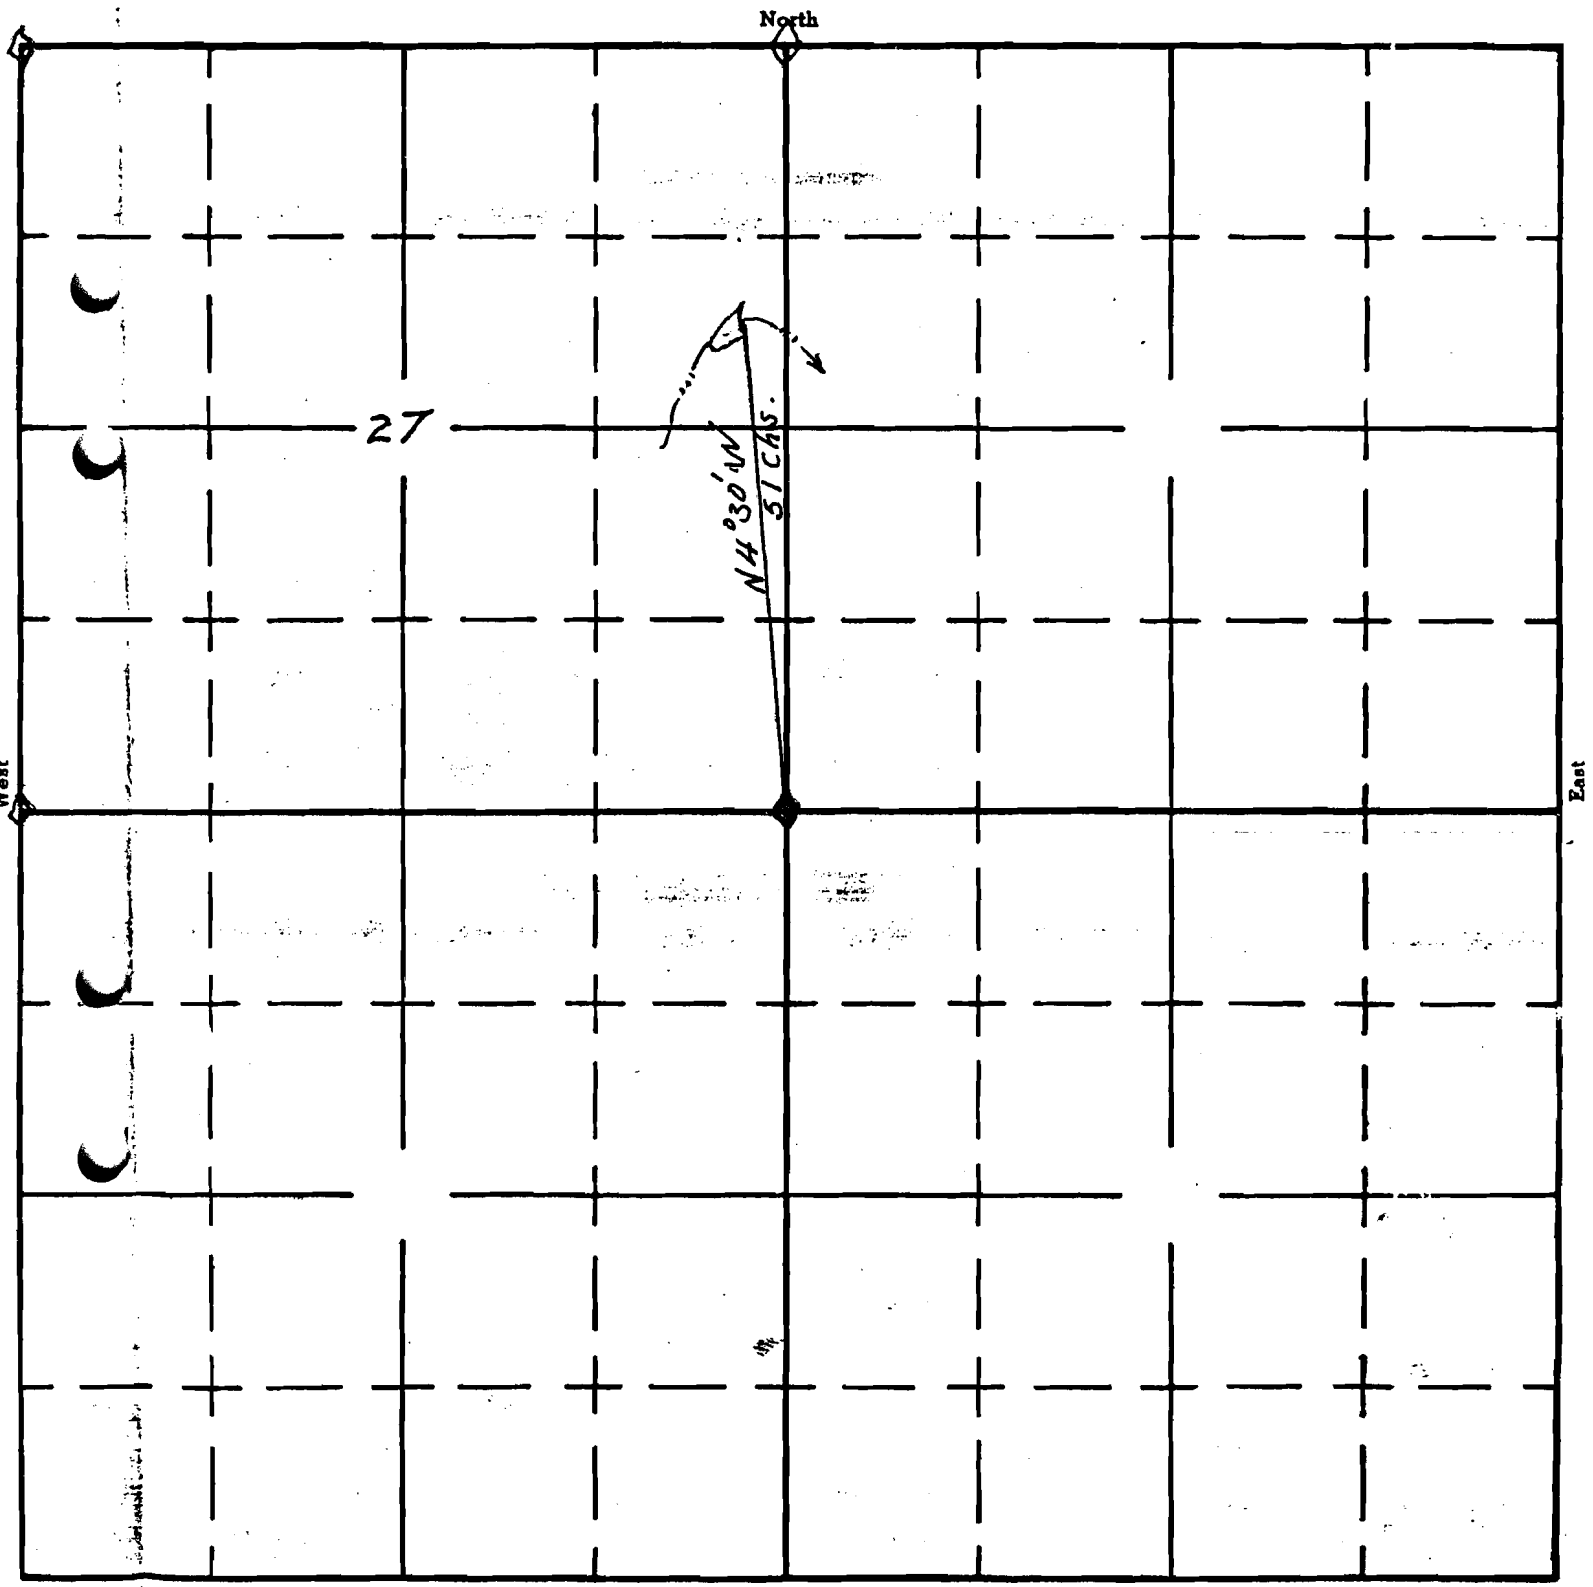

APPLICATION No. R-38359
PERMIT No. R-7351