

Form AI-187
March 1961

UNITED STATES
DEPARTMENT OF THE INTERIOR
BUREAU OF LAND MANAGEMENT

R 7353
51419

SECTION

32


Oregon State Water Filings

NE 1/4 SE 1/4

TOWNSHIP 40S, RANGE 24E, W. M.

RECEIVED
APR 5 1963
STATE ENGINEER
SALEM, OREGON

North

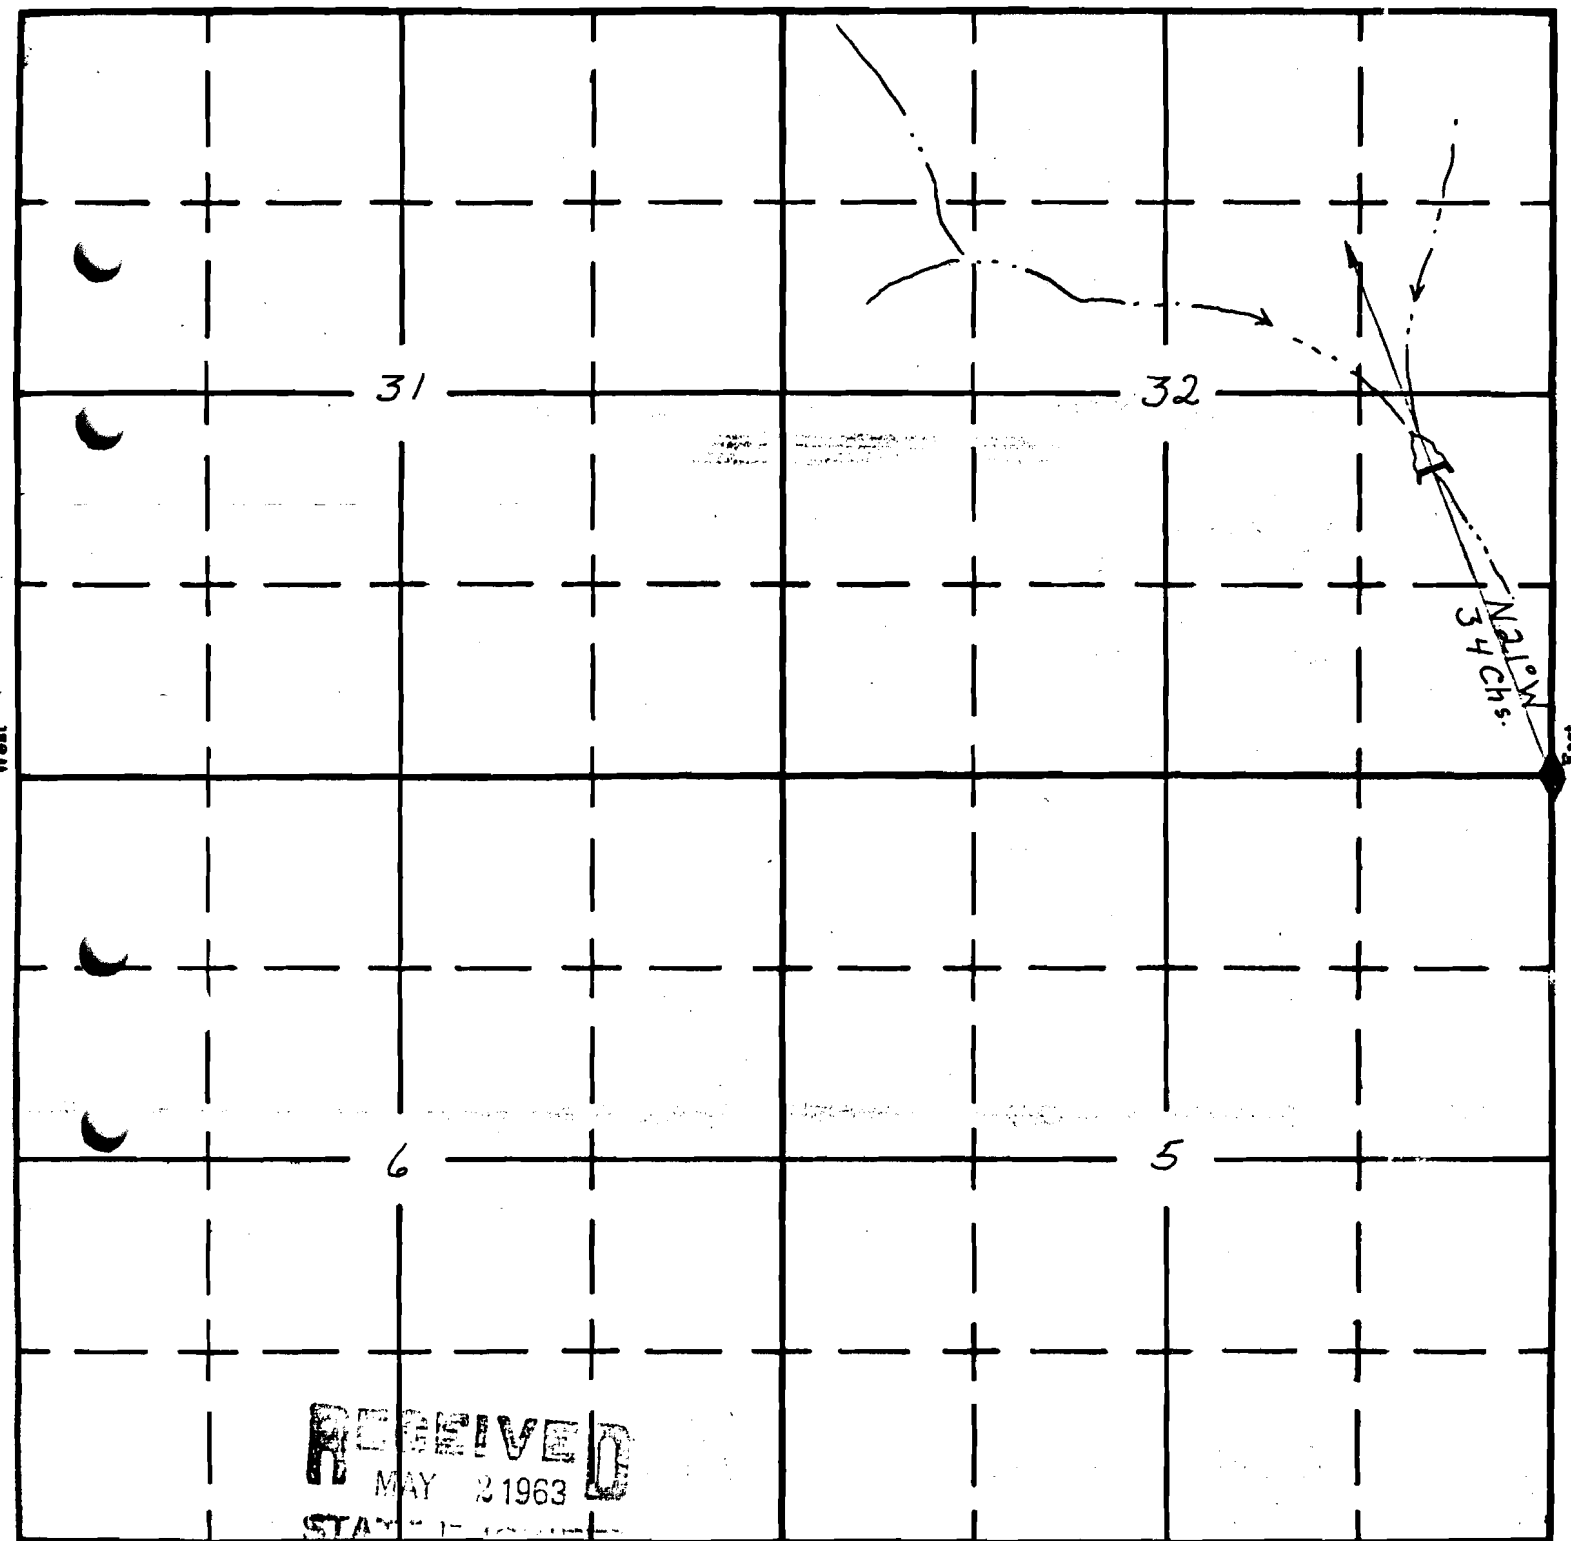

RECEIVED
MAY 2 1963
STATE ENGINEER
SALEM, OREGON

South

Valley Res.
01-R-246

APPLICATION No. R-38590
PERMIT No. 7353