


# T. 6S. R. 1W. W.M.

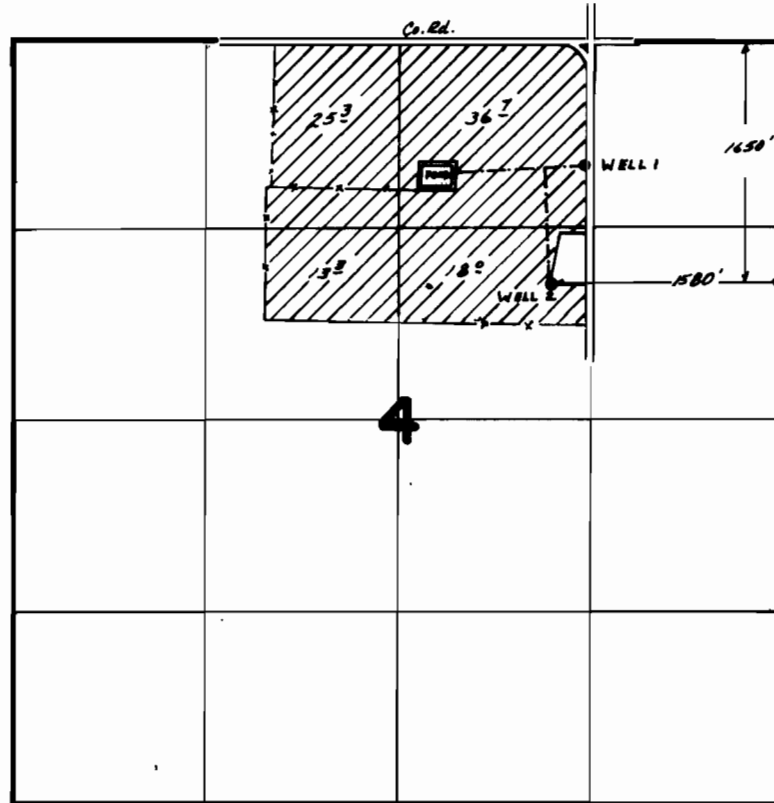

## FINAL PROOF SURVEY UNDER

Application No. G-6157 Permit No. G-5843.  
IN NAME OF

ARTHUR SCHWAB

Surveyed Oct. 5, 1978, by J.S. Donaldson.  
Inspection Sept. 9, 1981 by S.C. Brown