


T.6S.,R.1E.,W.M.

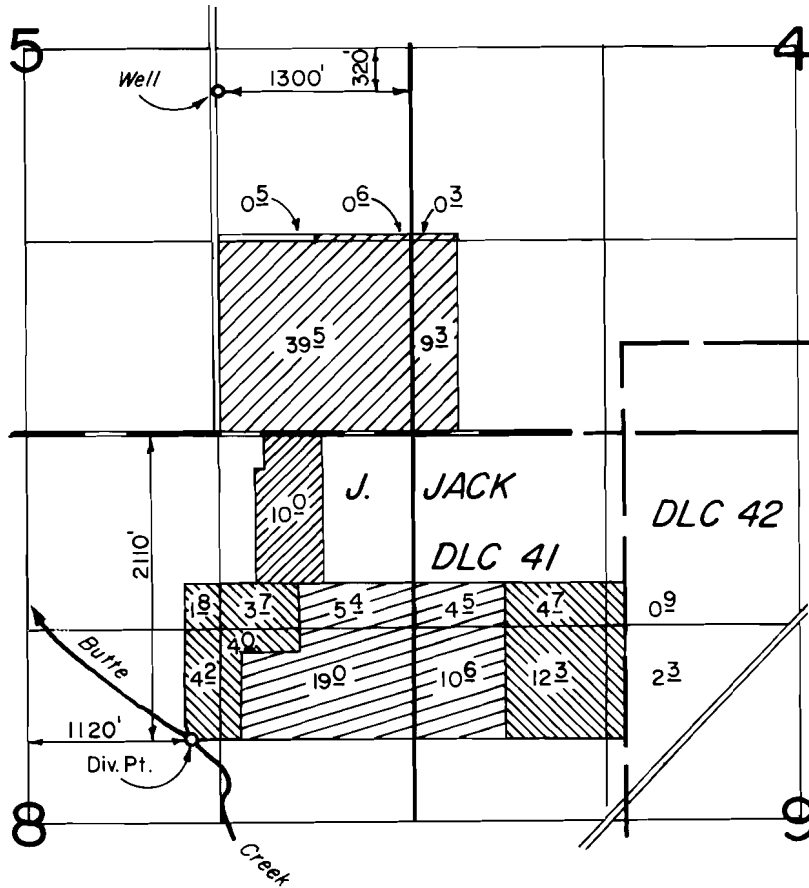

FINAL PROOF SURVEY

UNDER

G-7870
55397

G-7291
41538
42996

Application No. 57217 Permit No.

Supplemental
 Primary
 Primary Supplemental

IN NAME OF

VICTOR SCHNEIDER et al.

Surveyed MAY 1, 1978, by J. DONALDSON
MAY 19, 1980 *J. Brown*