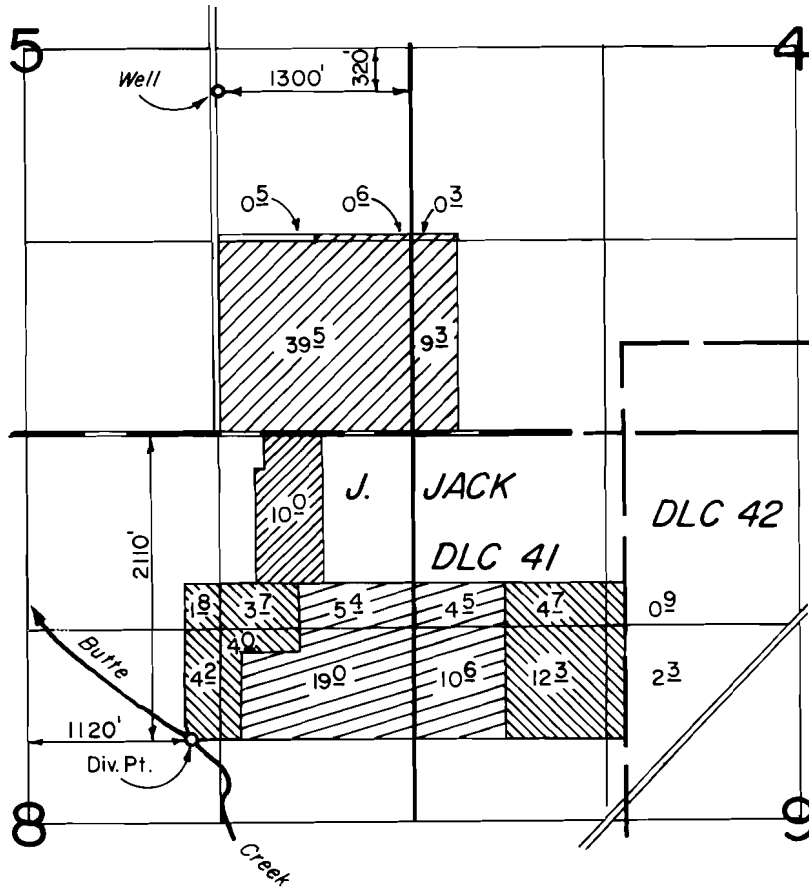
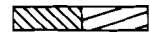

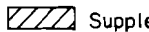



T.6S.,R.1E.,W.M.



FINAL PROOF SURVEY UNDER

G-7870 G-7291
 55397 41538
 Application No. 57217 Permit No. 42996

 Supplemental
 Primary
 Supplemental
 Primary

IN NAME OF

VICTOR SCHNEIDER et al.

Surveyed MAY 1, 1978, by J. DONALDSON
MAY 19, 1980

J. Brown

deb