


COPY OF MAP

R-52744

T.16S. R.24E., W.M.

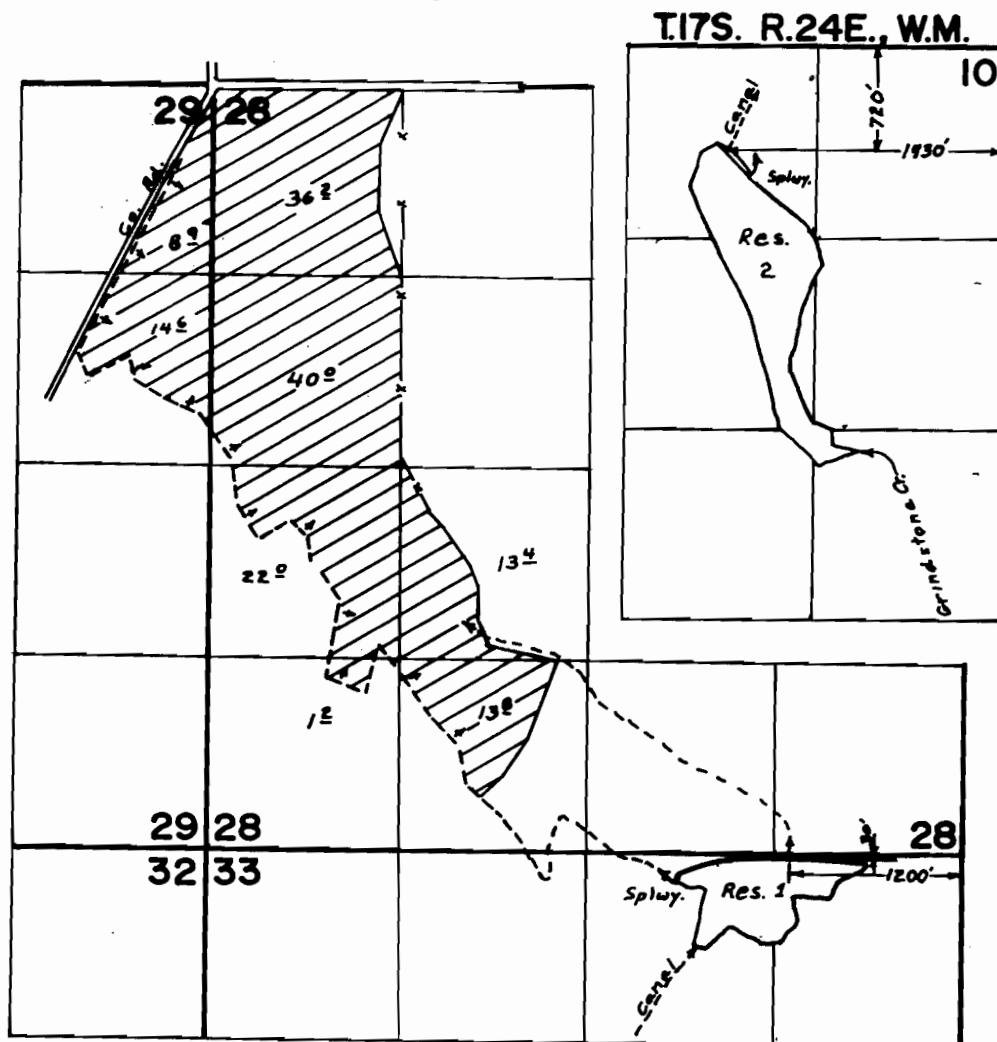

FINAL PROOF SURVEY UNDER

R-52743 R-6347
R-52744 R-6348
Application No. 52745 Permit No. 39462
IN NAME OF

BAR SEVENTY-ONE RANCH, INC.

Surveyed AUG. 3, 1978, by J. S. DONALDSON