
C51432

T.16S. R.24E., W.M.

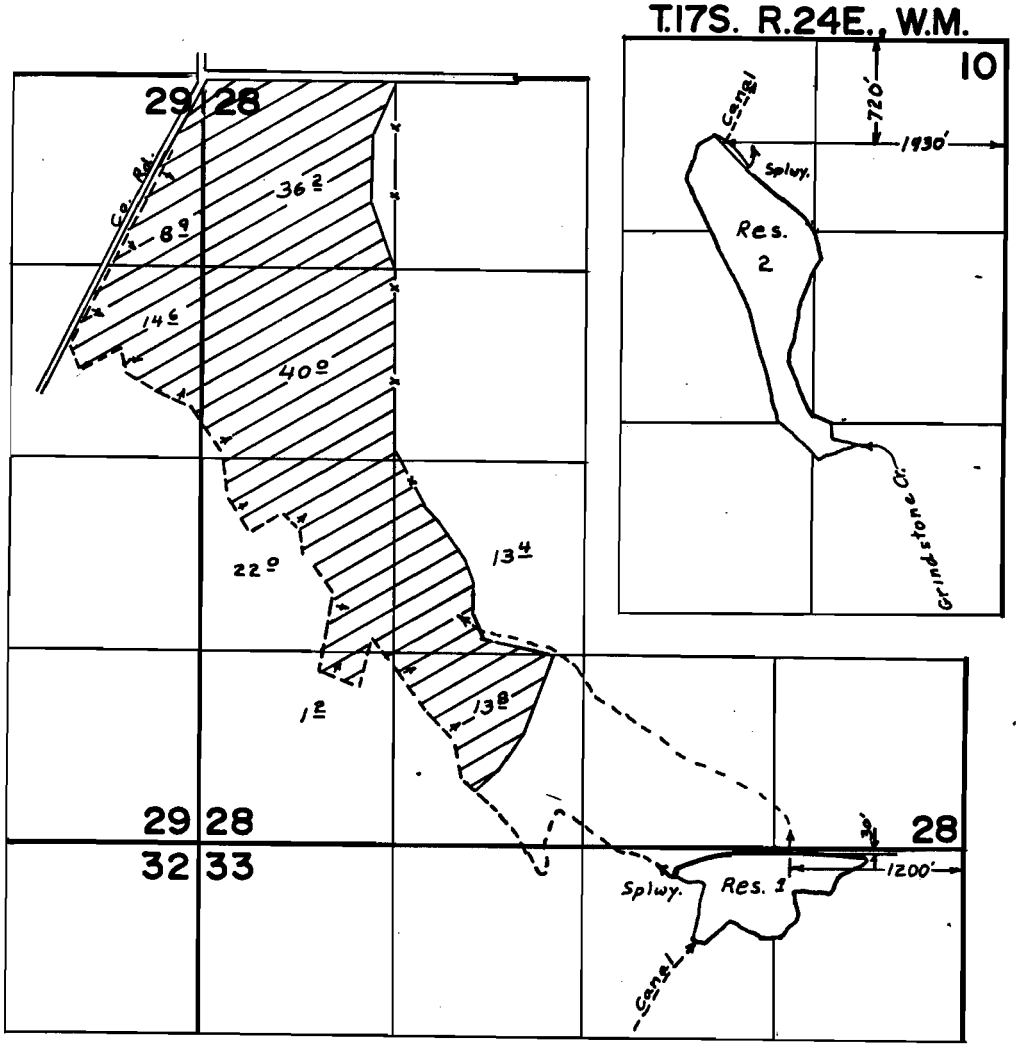

FINAL PROOF SURVEY

UNDER

R-52743 R-6347
R-52744 R-6348

Application No. 52745 Permit No. 39462

IN NAME OF

BAR SEVENTY-ONE RANCH, INC.

Surveyed AUG. 3 1978, by J.S.DONALDSON

1978-A-3

of

39462