


T. 26S., R. 3W., W.M.
SEC. 34

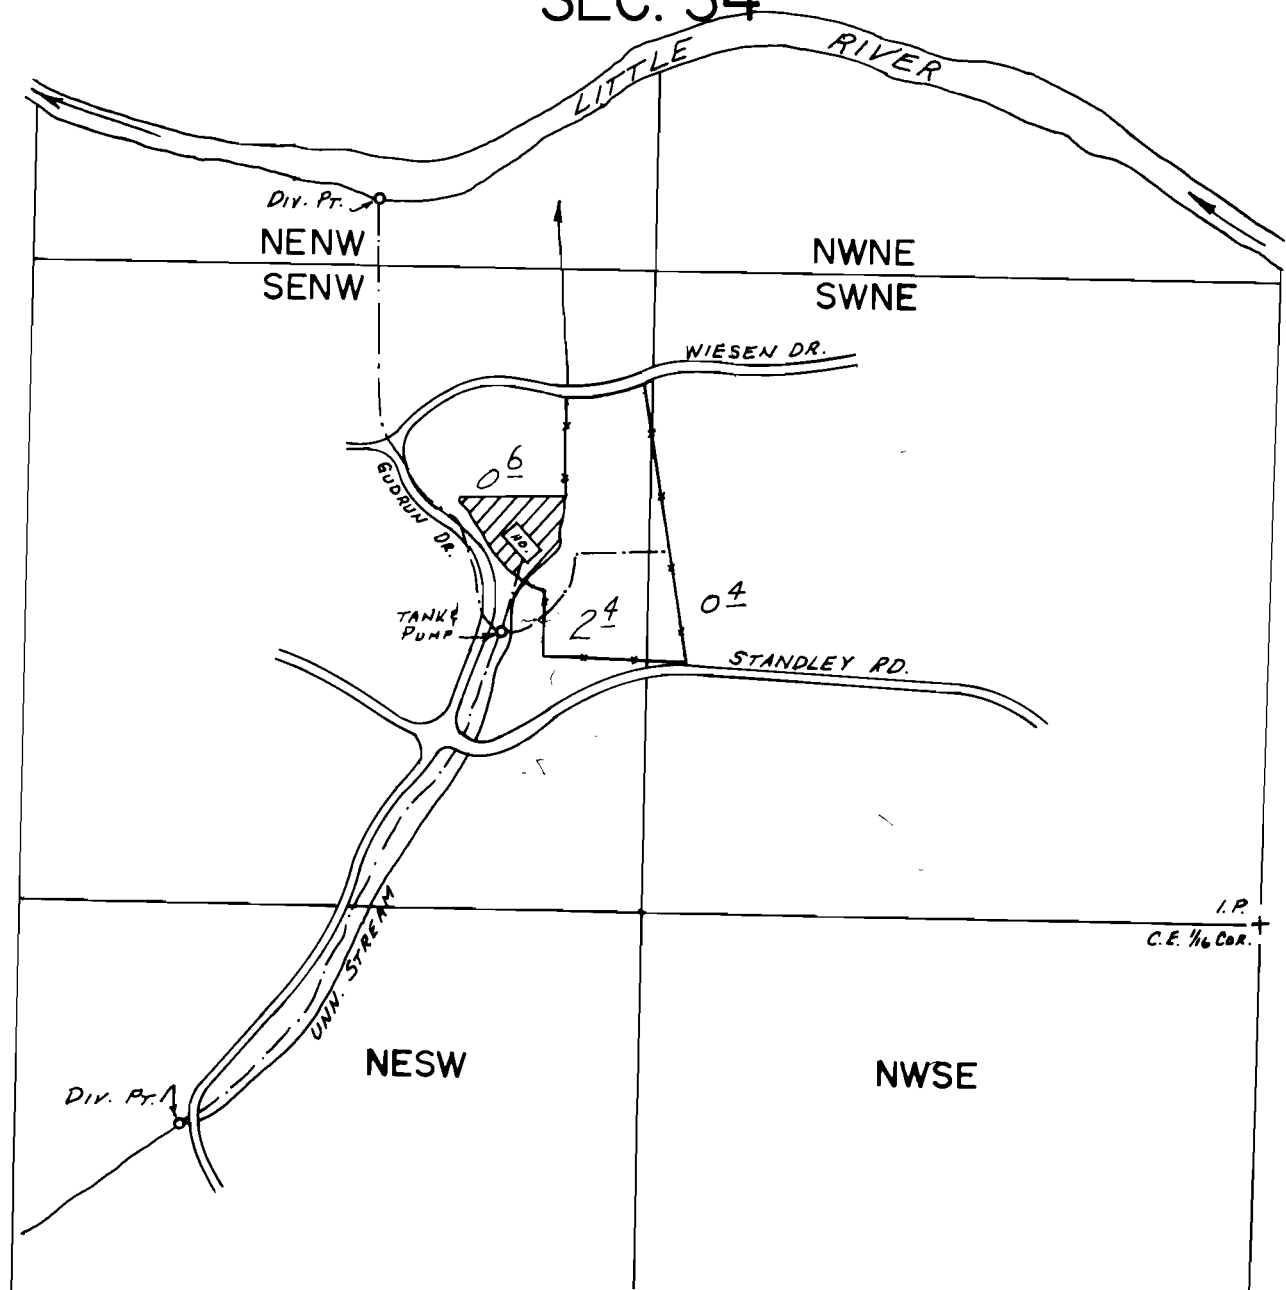

DIV. PTS. LOC: RIVER - 1490' N. & 1870' W.; STREAM - 460' S. & 2230' W.;
BOTH FROM CENTER E. 1/16 COR. SEC. 34.

FINAL PROOF SURVEY
UNDER

SCALE: 1" = 400'

Application No. 52057... Permit No. 39232.....
IN NAME OF

.....WAYNE A. SNYDER.....

Surveyed APR. 29. 19.80., by J.S. DONALDSON