


T.24S.,R.5W.,W.M.

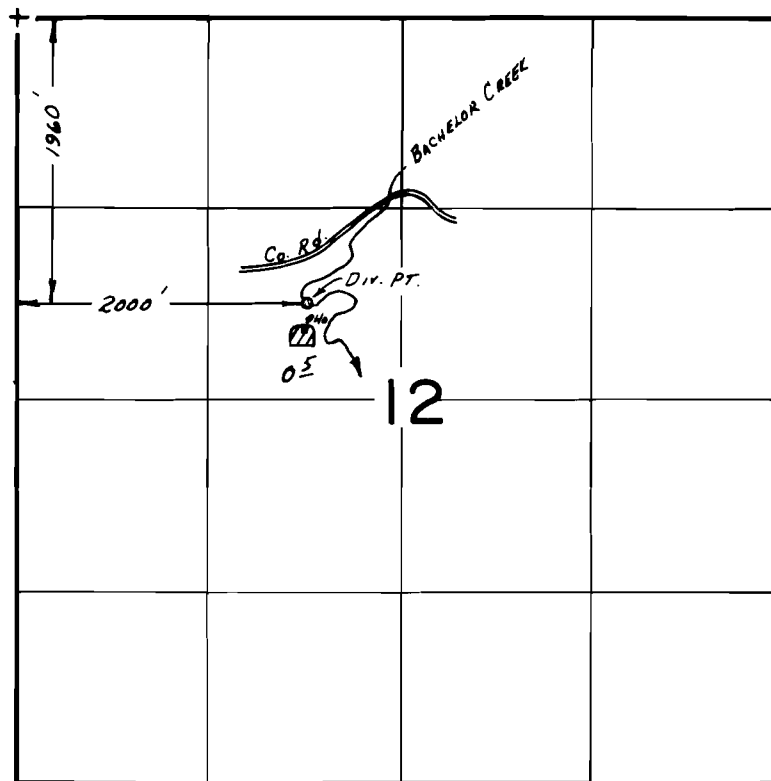

FINAL PROOF SURVEY
UNDER

Application No. 53385 39737
58921... Permit No. 44440.....
IN NAME OF

PETER M. STRASENBURGH.....

Surveyed AUG. 1..... 19.79, by J.S. DONALDSON
MAY 20 1980