



T. 13S. R. 30E. W.M.

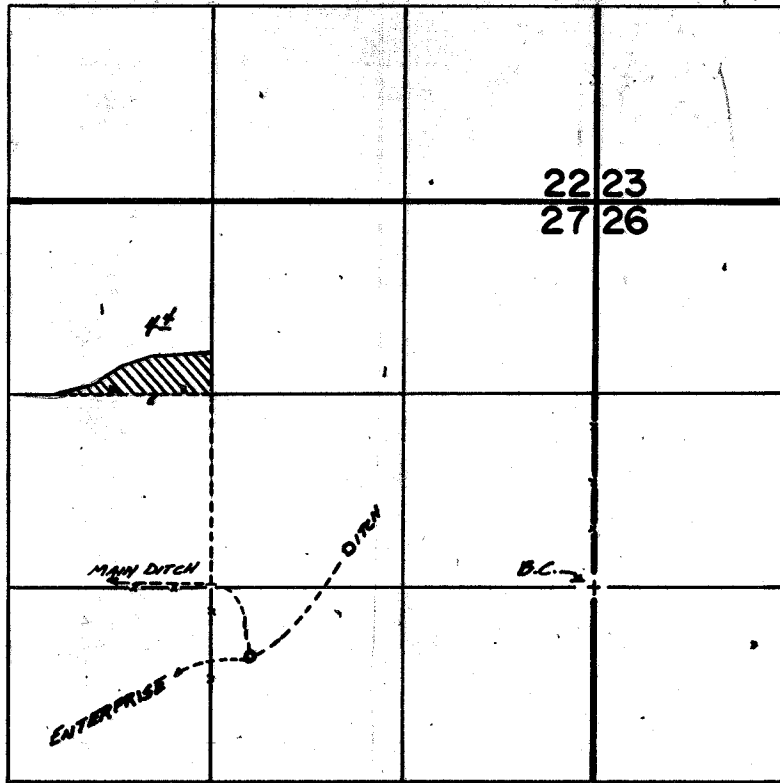

T. 13S. R. 31E. W.M.

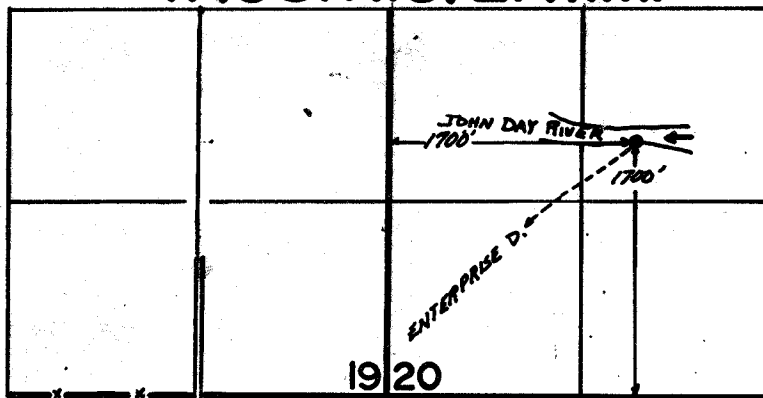

FINAL PROOF SURVEY UNDER

Application No. 39987.. Permit No. 29786..
IN NAME OF

.....*Donald K. McKel*.....

Surveyed Sept. 17, 1977, by S.C. BROWN.....
" June 9, 1978, " J.S. Donaldson