


P-38853  
51448

# T9S. R27E. WM.

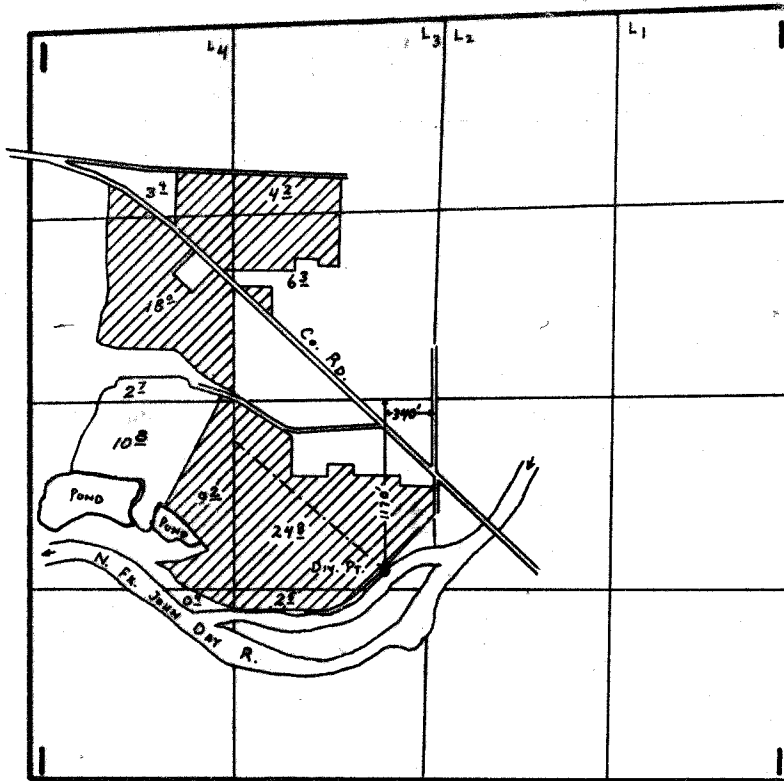

## FINAL PROOF SURVEY UNDER

Application No. 51386... Permit No. 38853.....  
IN NAME OF

**JACK O. SWEET & JACK E. CAVENDER**

Surveyed Oct. 13, 1977, by S. C. BROWN.....