

Form AI-187
March 1961

UNITED STATES
DEPARTMENT OF THE INTERIOR
BUREAU OF LAND MANAGEMENT

R 7043
51444


SECTION 9

Oregon State Water Filings

SE 1/4 NE 1/4

TOWNSHIP 31 S, RANGE 26 E, W. M.

Tied in with aerial photos & O.S.H.D. Quad Maps

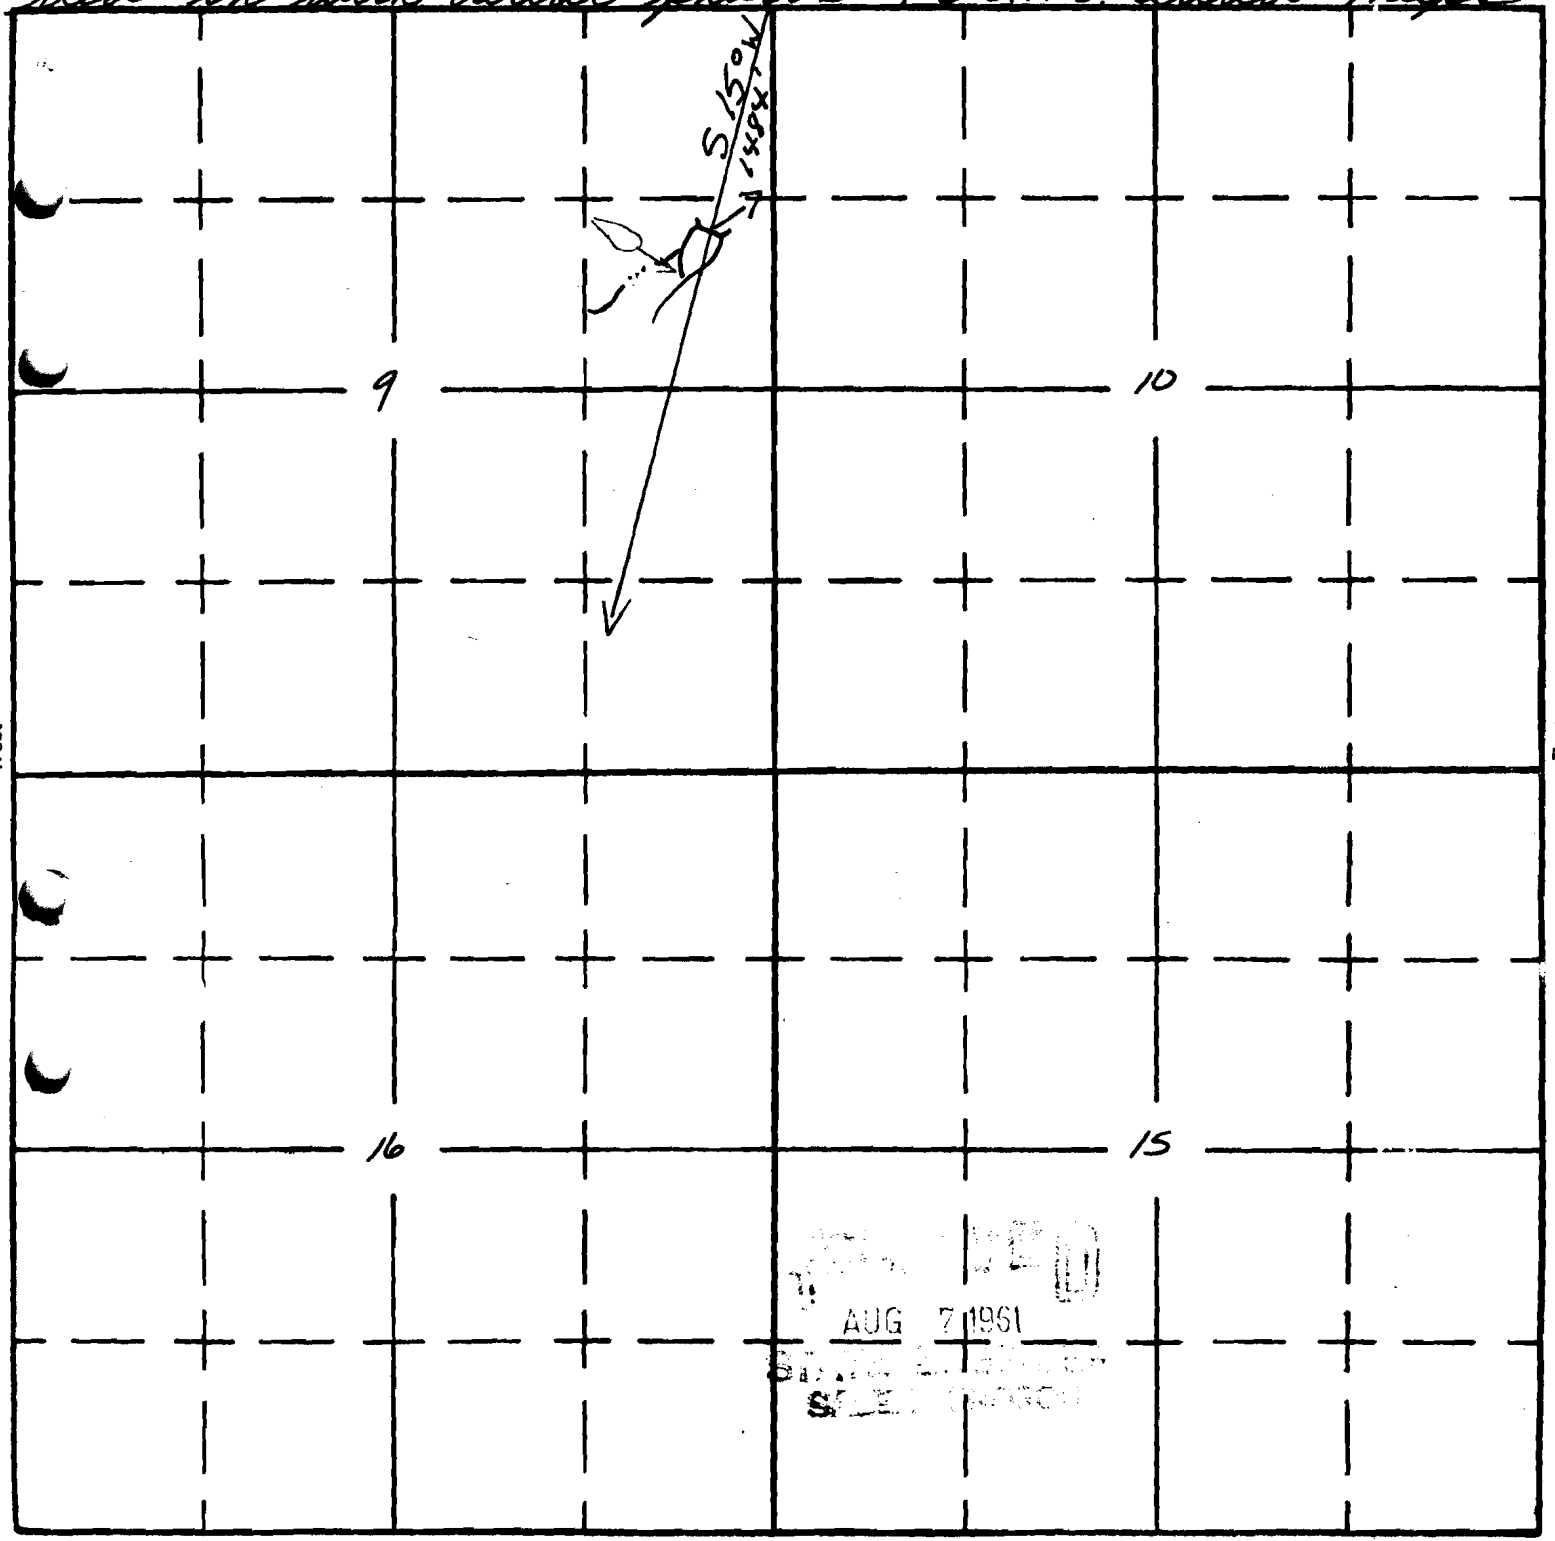

Red Bank Lakes 7 1/2' quad

APPLICATION No. R-36181
PERMIT No. R 7043