


T. 24 S., R. 27 E., W.M.

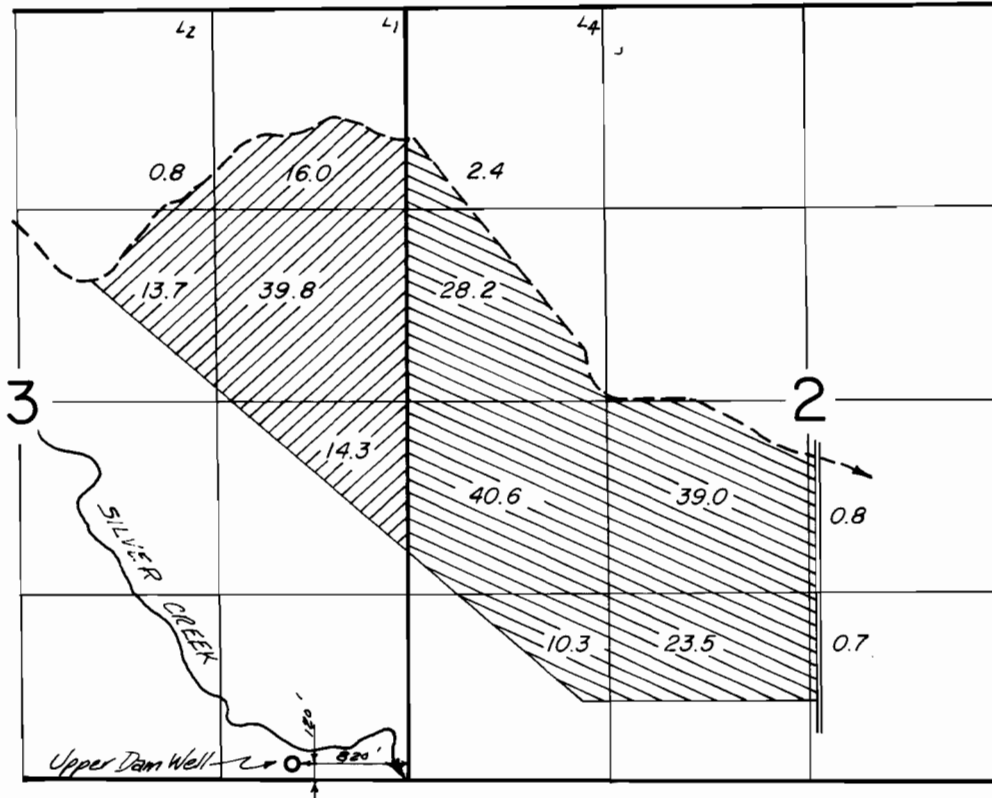

FINAL PROOF SURVEY UNDER

Application No. G-6729 Permit No. G-5256
IN NAME OF

James Towery, Robert Young, Vernon Morgan

Surveyed Aug 19, 1976, by R.G. Mucken