




~~28809~~ 7  
25083

# T.S.R. IOE.W.M.

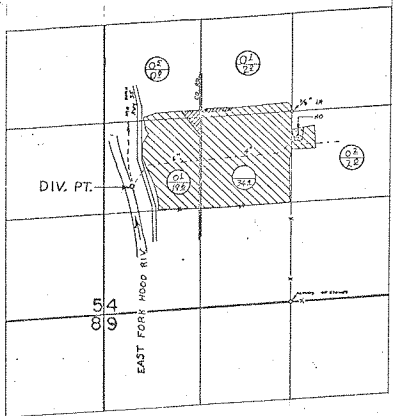

DIV. PT. LOC. 1020'S. 2180'W. FROM CEN. SEC. 4  
 ○ PRIMARY  
 ○ SUPPLEMENTAL

## FINAL PROOF SURVEY UNDER

~~Application No. 38553~~ Permit No. 28809  
 IN NAME OF

..ARTHUR M. AND DOROTHY BIBB.....

Surveyed MAY. 26. 1971. by R. MUCKEN.....

This map shows the location of this water right permit 25083 (supplemental lands) prior to filing transfer 5154. T.S.R. transfer out 1<sup>st</sup> acre from NE 1/4 SW 1/4 LMT.