


T. 35 S., R. 3 W., W.M.

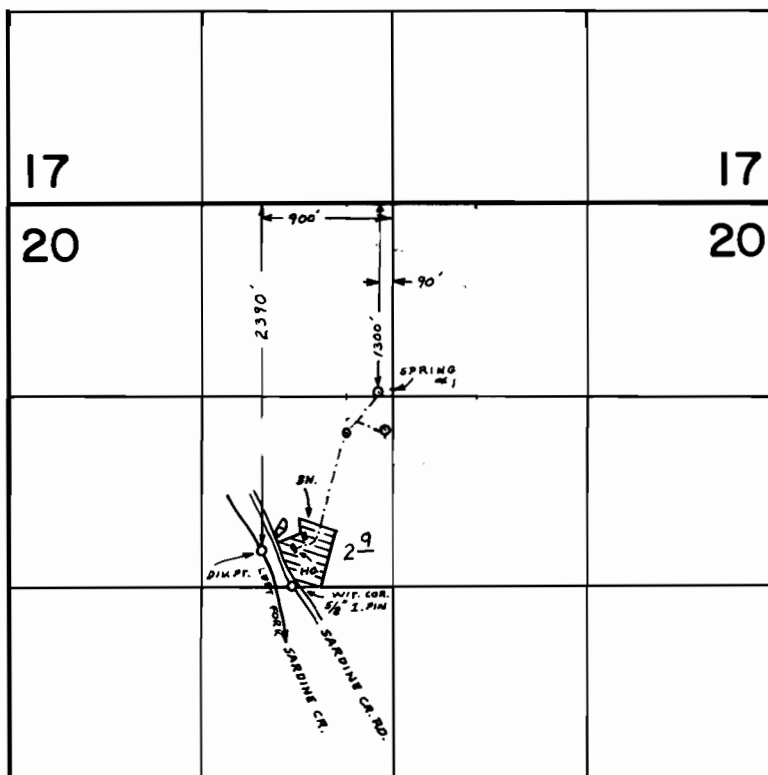

FINAL PROOF SURVEY UNDER

Application No. 48329 Permit No. 36292
IN NAME OF

MICHAEL ELLIS

Surveyed SEPT. 19 78 by B. SUND
19..... by