


T. 37 S., R. 4 W., W.M.

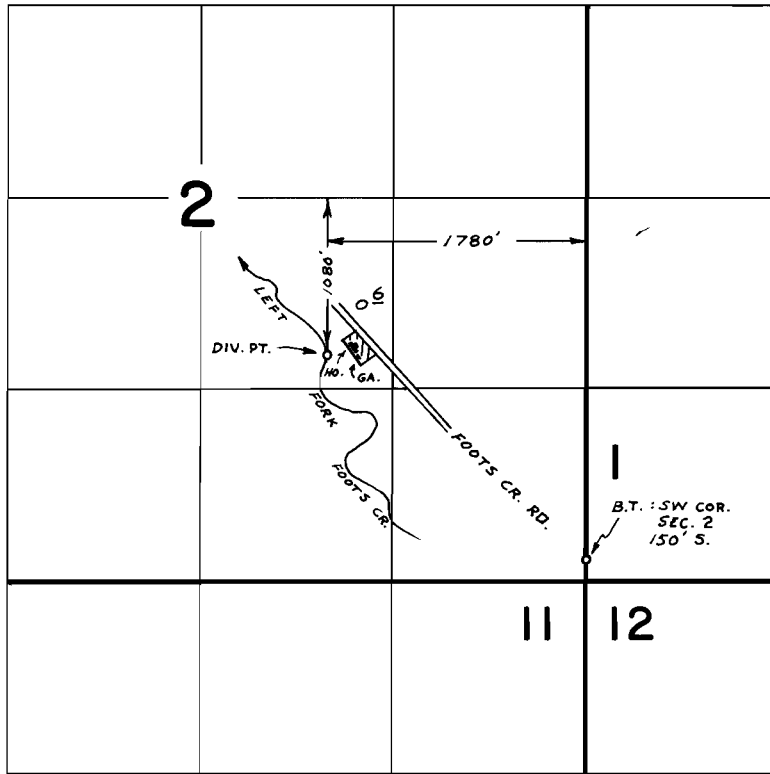

**FINAL PROOF SURVEY**  
UNDER

Application No. 51089 Permit No. 38546  
IN NAME OF

*Robert G. & Norma S. Haworth*

Surveyed SEPT. 22 1978, by B. SUND