


T. 35 S., R. 3 W., W.M.

T. 35 S., R. 4 W., W.M.

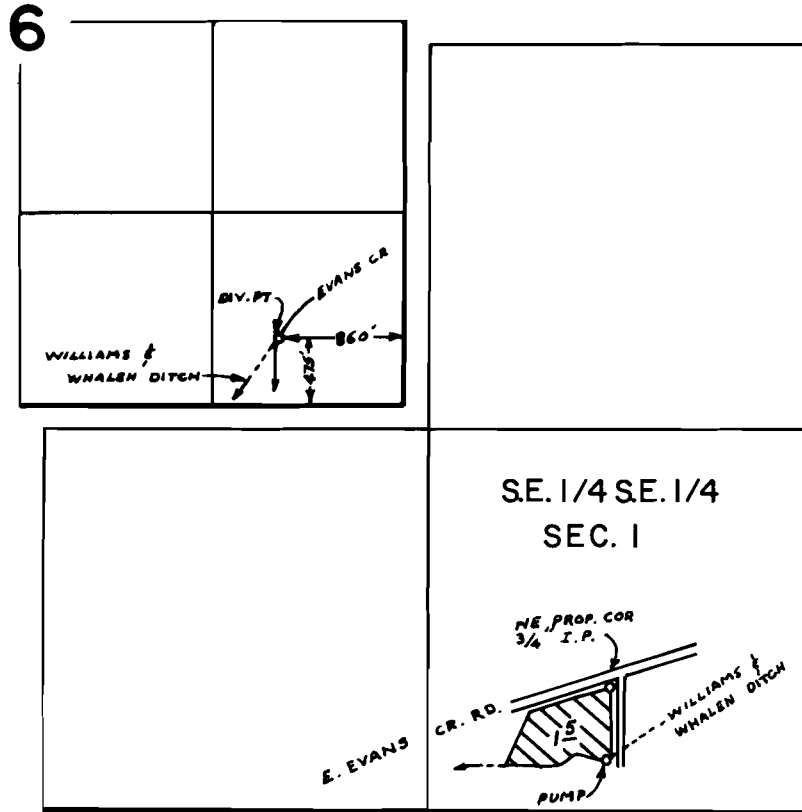

SCALE : 1" = 660 FT.

FINAL PROOF SURVEY
UNDER

Application No. 53429 Permit No. 39757
IN NAME OF

..... Douglas L. & Lucinda W. Buysman

Surveyed MAY 16 78 B. SUND
19....., by