


T. 40 S., R. 4 W., W.M.

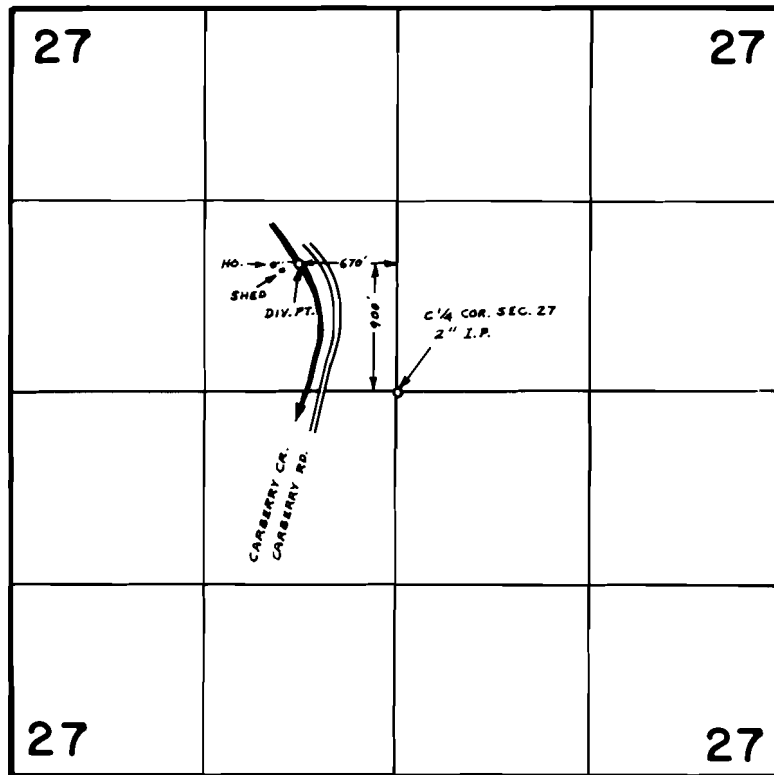

FINAL PROOF SURVEY
UNDER

Application No. 54326 Permit No. 40729
IN NAME OF
ARTHUR &/OR AGNES REHFELD
Surveyed JUN. 19 1978, by B. SUND