COPY

T. 36S., R. 4 W., W.M.

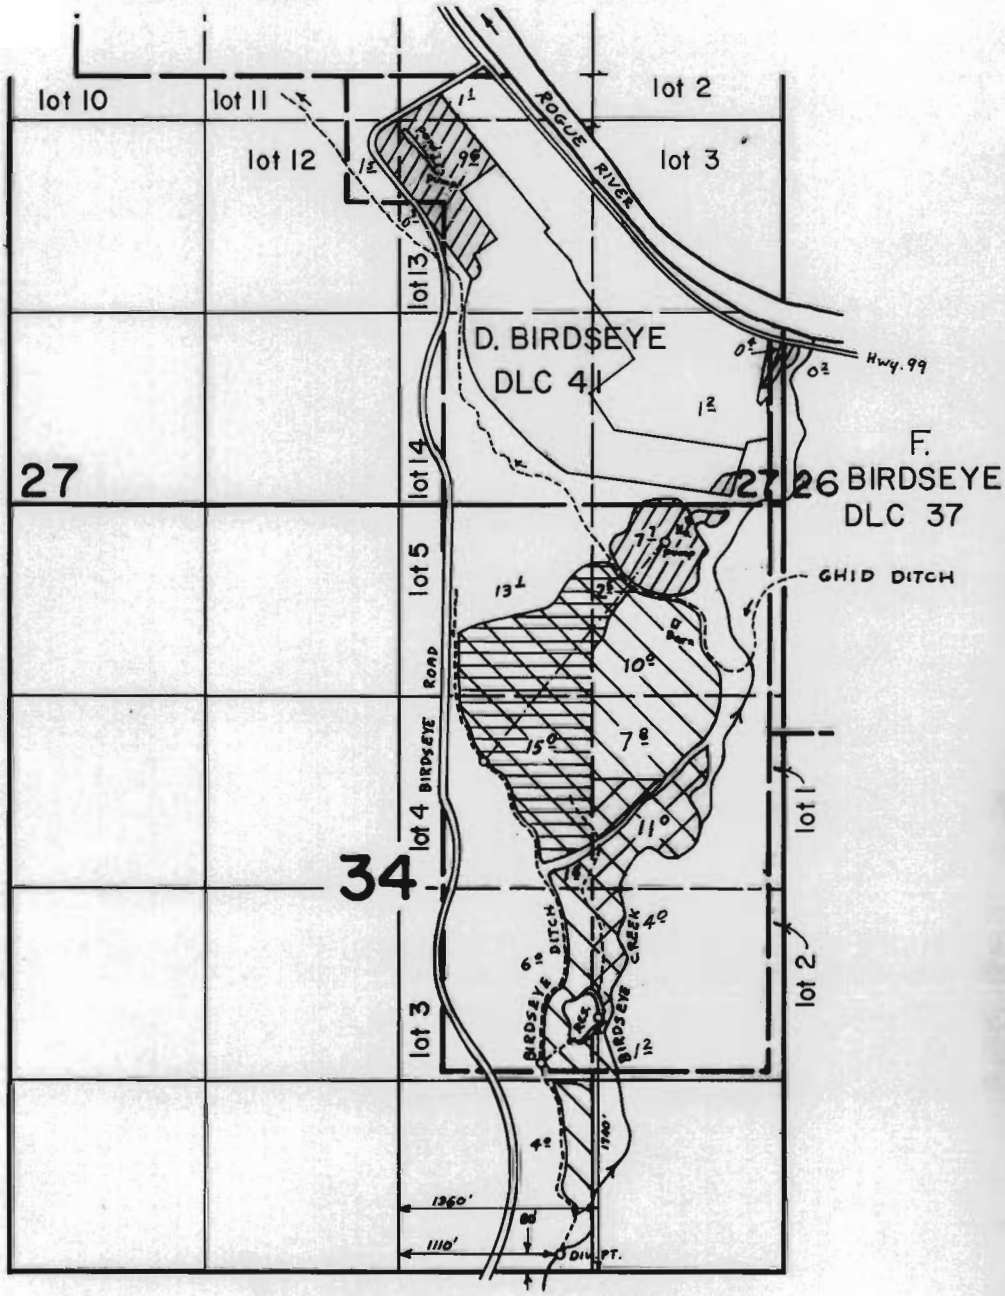

Scale 4" = 1 mile

FINAL PROOF SURVEY

UNDER

Transfer no. B-209 &

46626 34894

R-51696 R-6249

Application No. 51697.... Permit No. 38833.....

IN NAME OF

.....GLENN C. BIRDSEYE.....

Surveyed July 15,.. 1980, by B.R. SLIND.....

Tr. no. B-209

46626

46626 - July 1.

51697 supp'l.

B50-10-3 BSJ