


T.35 S., R.5 W., W.M.

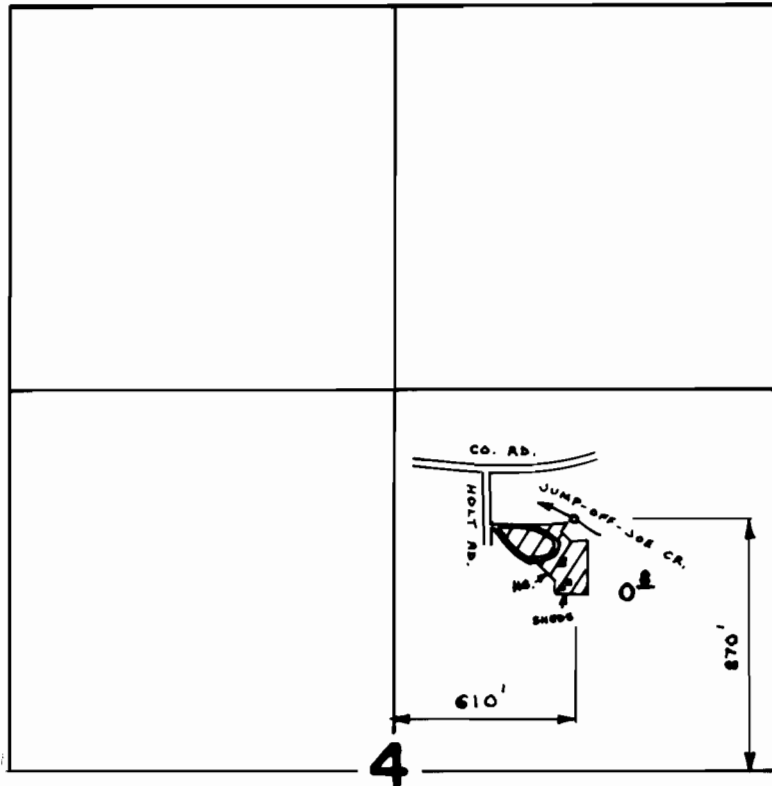

SCALE : 1" = 660 FT.

FINAL PROOF SURVEY
UNDER

Application No. 49165 Permit No. 36859
IN NAME OF

Cornelius D. Duggan III

Surveyed SEPT. 25 1978, by B. SUND

D.H.M.
PTS. - 1978-14-C