

Form A1-187
March 1961

UNITED STATES
DEPARTMENT OF THE INTERIOR
BUREAU OF LAND MANAGEMENT

R 7369

SECTION

8


Oregon State Water Filings

51462

NENE

TOWNSHIP 40-S, RANGE 26-E, W. M.

North

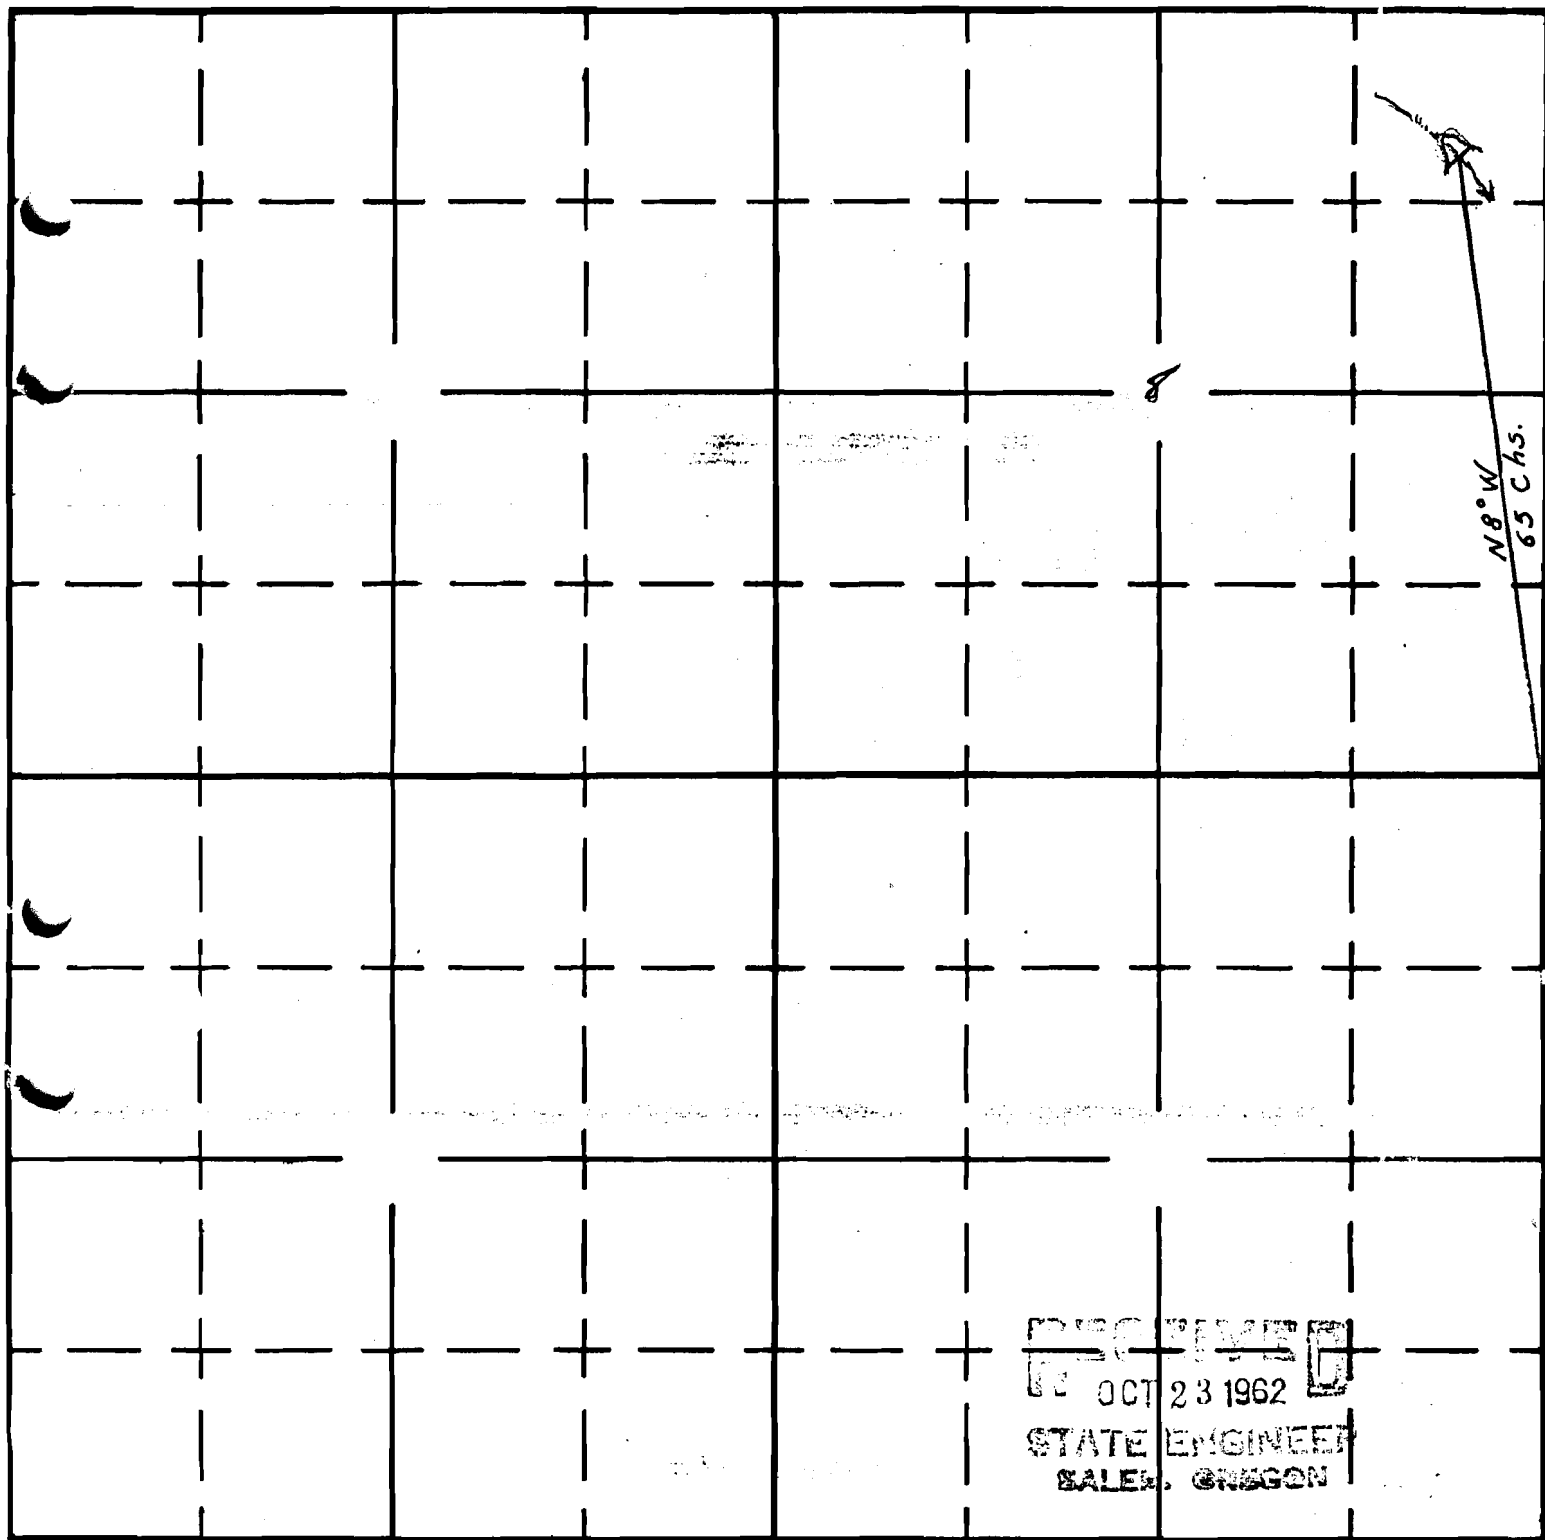

Blizzard Gap 7 1/2' quad

South

Final Proof
APPLICATION No. 38188
PERMIT No. R 7369