

Form AI-187
March 1961


UNITED STATES
DEPARTMENT OF THE INTERIOR
BUREAU OF LAND MANAGEMENT

SECTION

Sec. 27
NE 1/4, NE 1/4

Oregon State Water Filings

TOWNSHIP 32S, RANGE 23E, W. M.

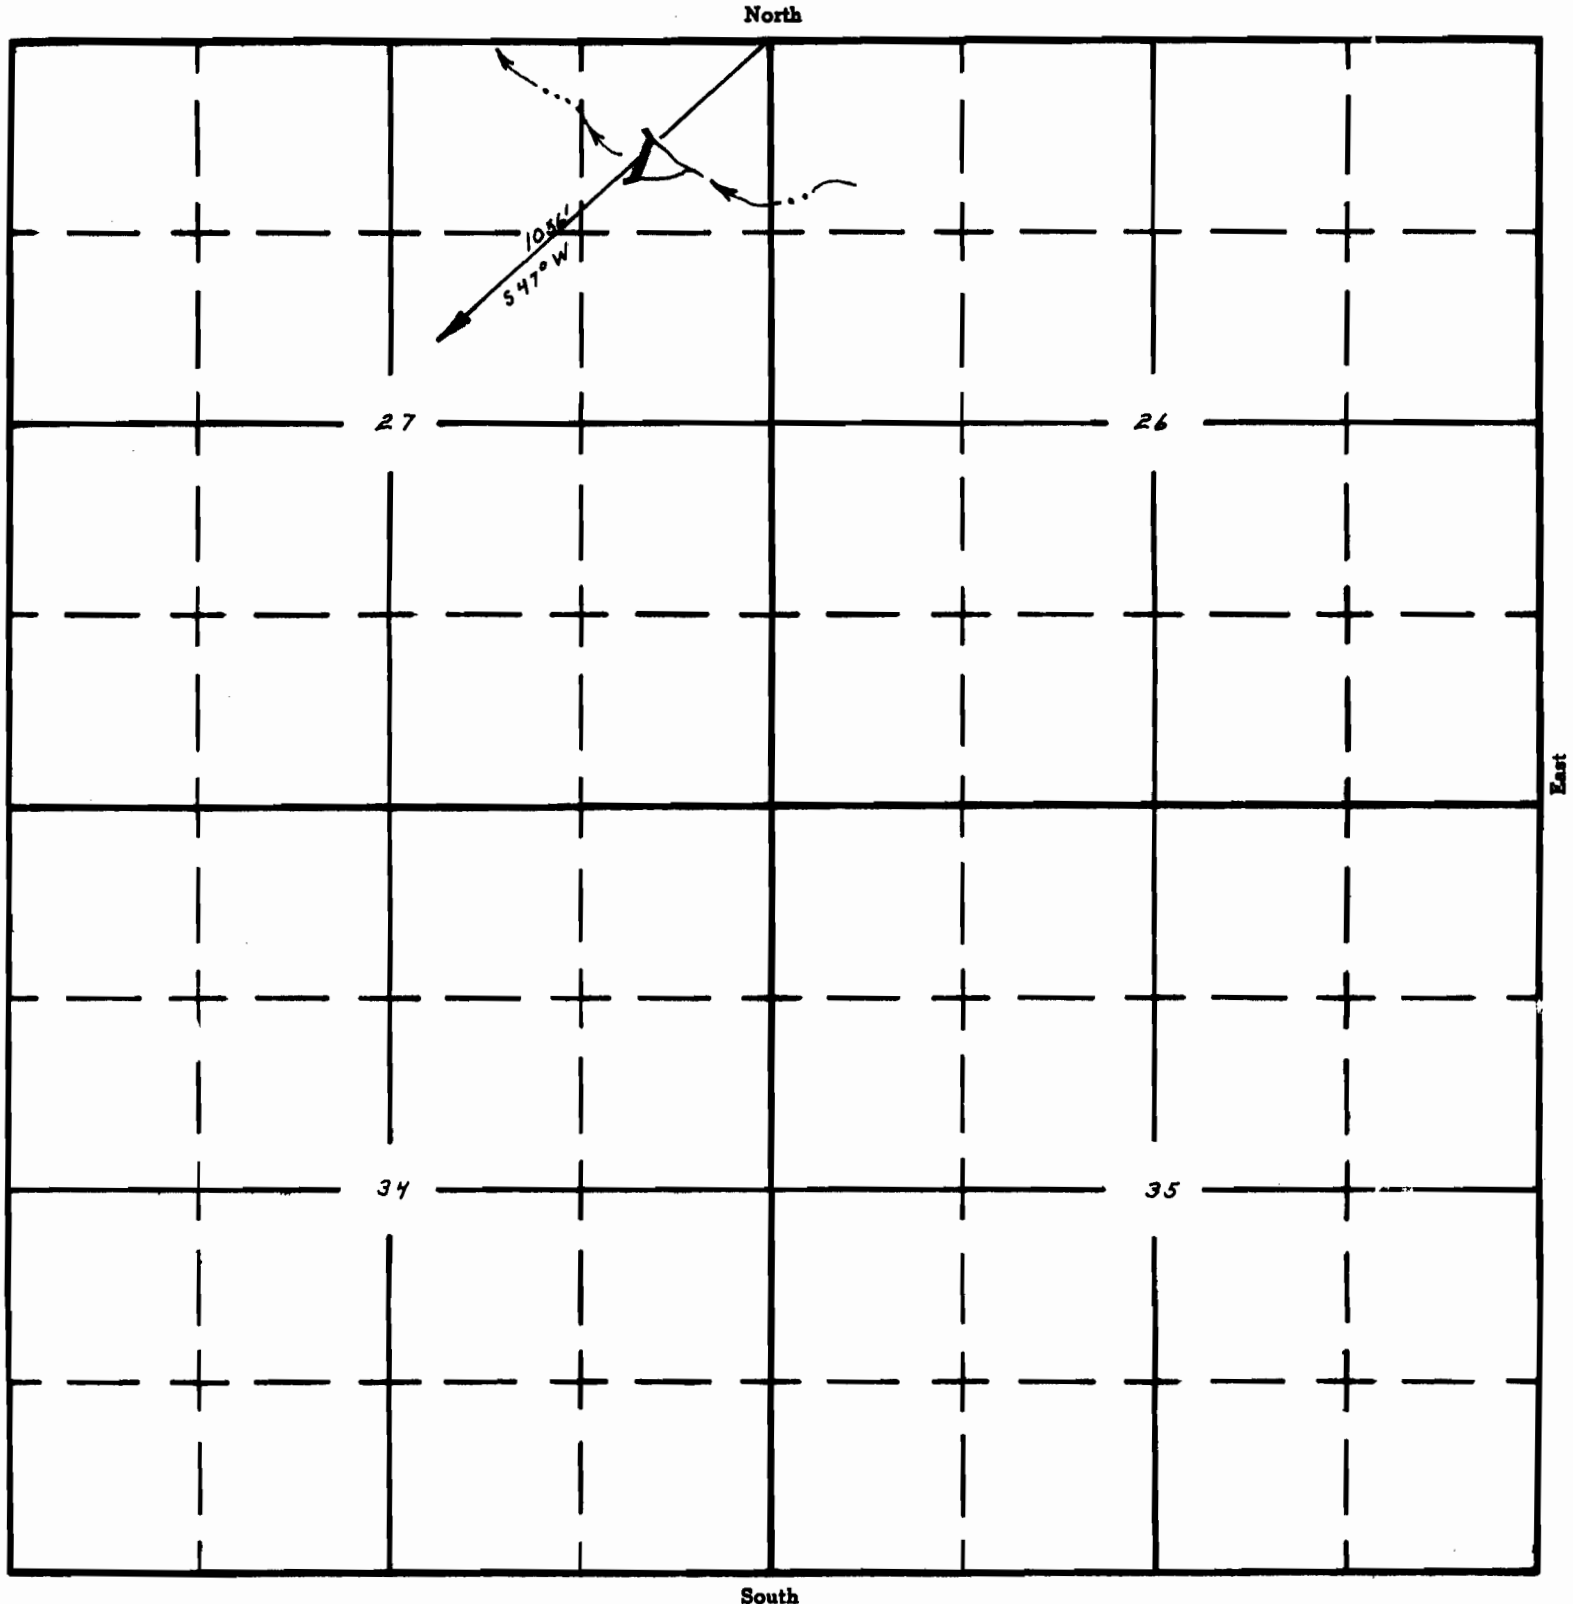

Ark Camp Water hole
91 - 160 - 128

APPLICATION No. A36257
PERMIT No. R 7087