


G 5522
51465

T.26S. R.15E., W.M.

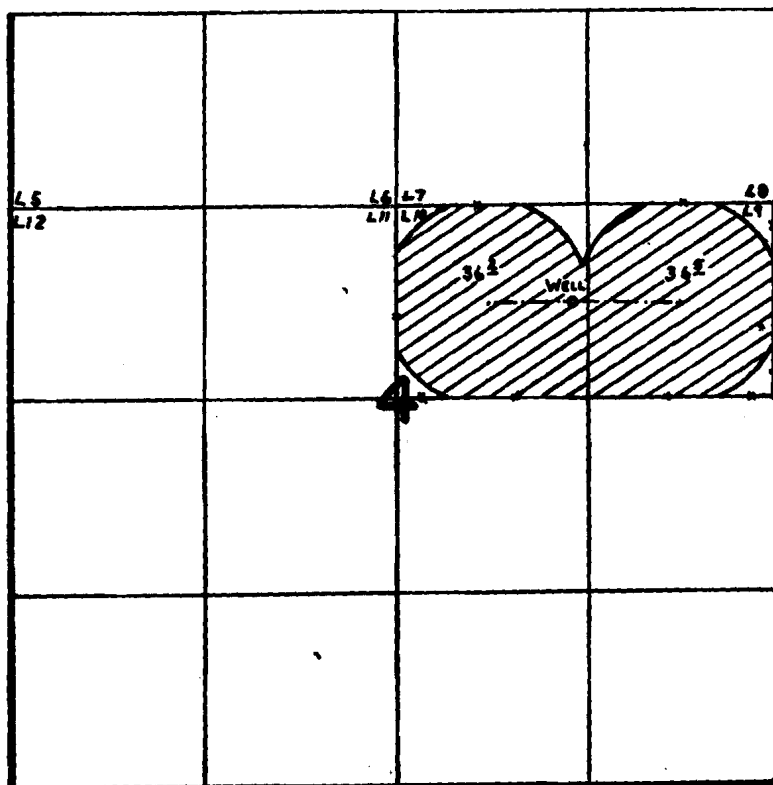

WELL LOC. 650' N. & 1210' E. FROM C. W. COR. SEC. 4

FINAL PROOF SURVEY
UNDER

Application No. G-5721... Permit No. G-5522..
IN NAME OF

.....RAY B. or E. M. WAGNER.....

Surveyed JUL. 16, 1977, by D. M. NORBY.....
AUG. 29, 1979, by C. L. HUGHES

PTS - 1979 - M
CH2-JRK-58

CLM
204