T17S. R1E. WM.

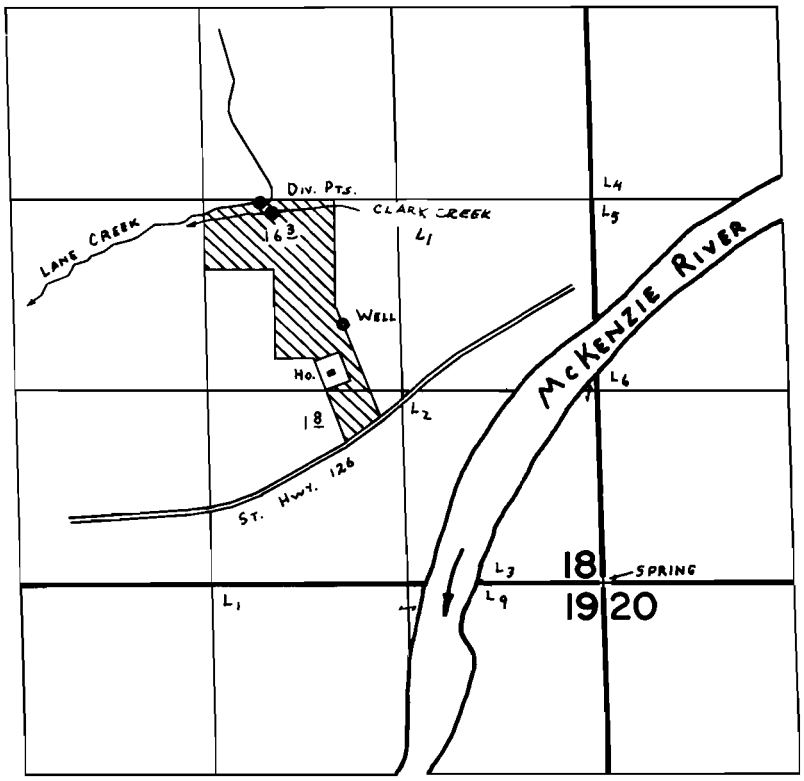

LANE CR. DIV. PT. LOC: 30' S. & 380' E.
WELL LOC: 860' S. & 950' E.
CLARK CR. DIV. PT. LOC.: 80' S. & 460' E.
} ALL FROM CENTER SEC. 18.

FINAL PROOF SURVEY
UNDER

54002 G-6006 — 40677 G-5674

Application No. 48960 Permit No. 36659

IN NAME OF

RICHARD L. NULL

Surveyed JULY 18 1978, by C. L. HUGHES
Surveyed JUNE 28 1979, by S.C. BROWN

DBG-6H-82