


T.15 S., R.10 W. W.M.

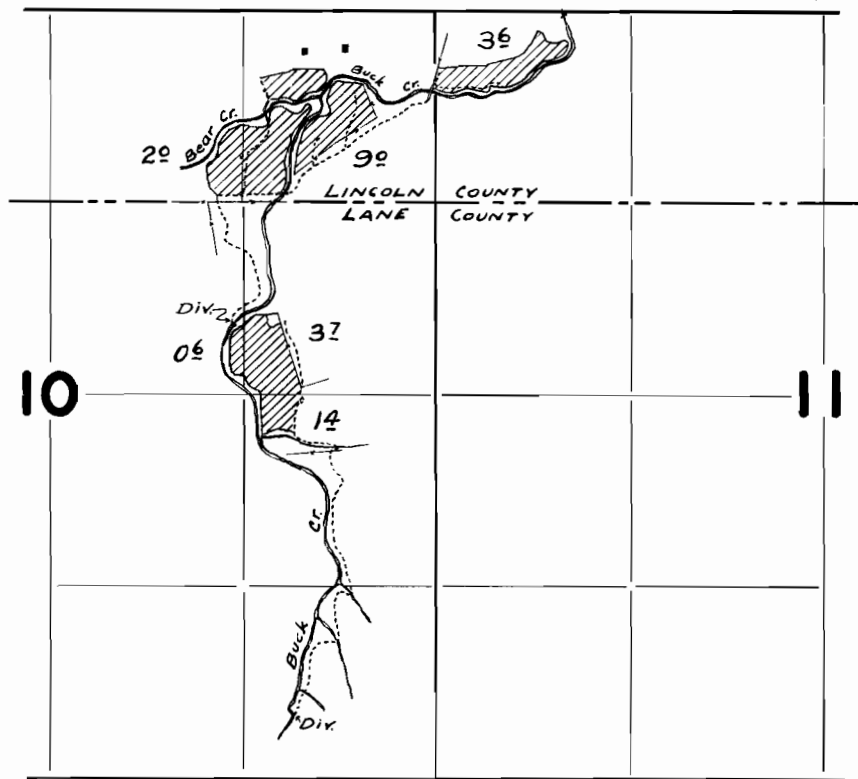

FINAL PROOF SURVEY
UNDER

Application No. 17553 Permit No. 13256

IN NAME OF

L. J. Bales

Surveyed Sept 12 1942, by Geo. Maderman