


T.6S.R.1&2W.W.M.

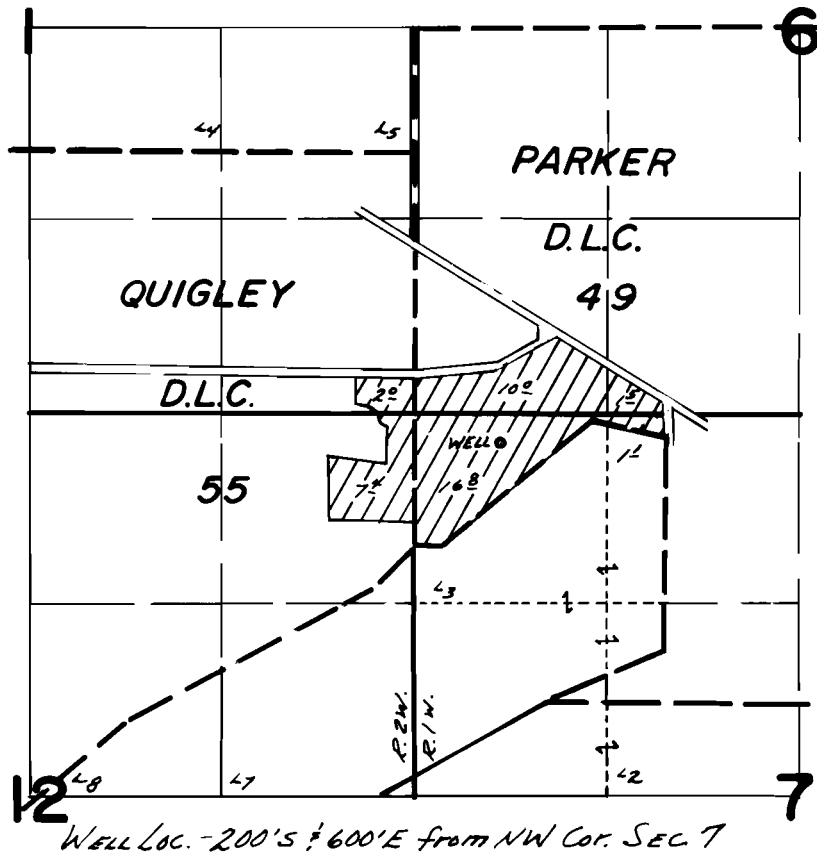

FINAL PROOF SURVEY UNDER

Application No. G-5380 Permit No. G-5311
IN NAME OF

MRS. CLARA JOHNSON

Surveyed Oct. 4, 1978, by J.S. Donaldson