


T.3 S.R.2 W.W.M.

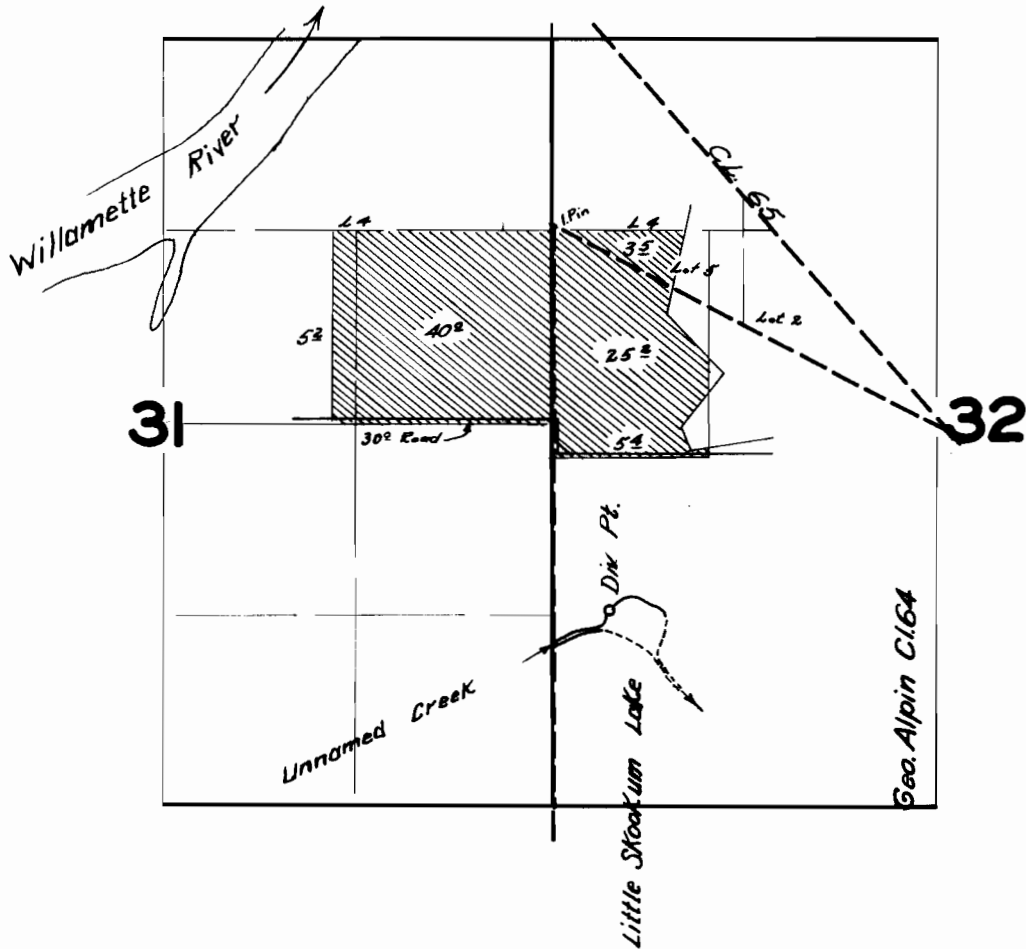

FINAL PROOF SURVEY UNDER

Application No. 23767 Permit No. 18078

IN NAME OF

HILLER BROTHERS & FRED HILLER

Surveyed 9/23 1952, by H. L. COFFMAN