


T.9S.R.3W.W.M.

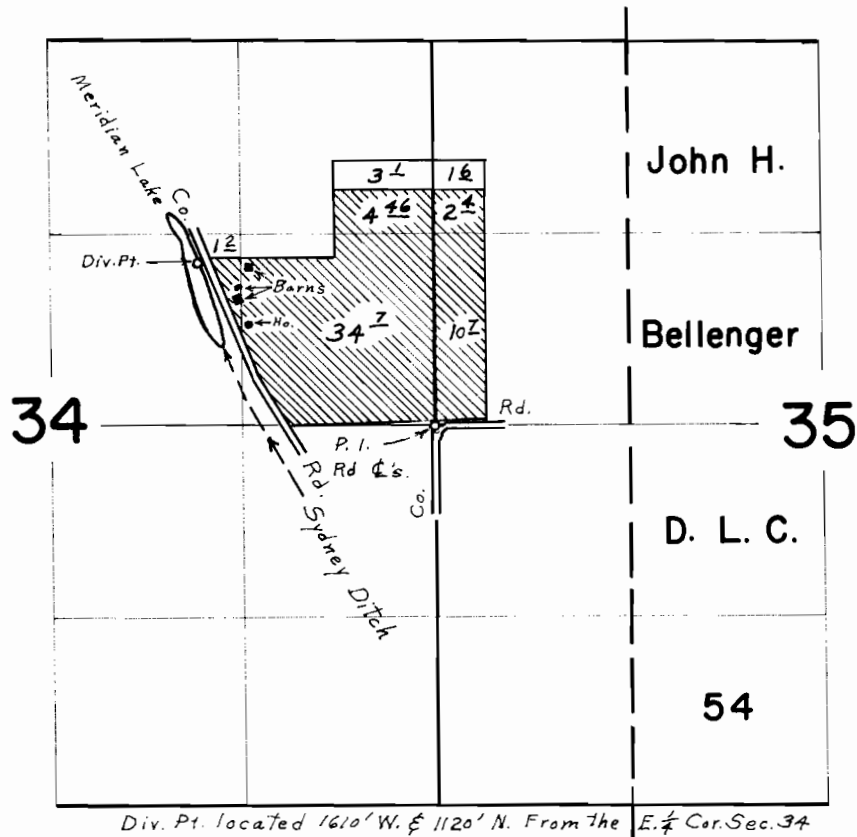

FINAL PROOF SURVEY UNDER

Application No. 37405 Permit No. 27860
IN NAME OF
LOUIS E. FRICK

Surveyed April 4, 1967, by L. E. Gould