


T.4S. R.2&3W. W.M.

245

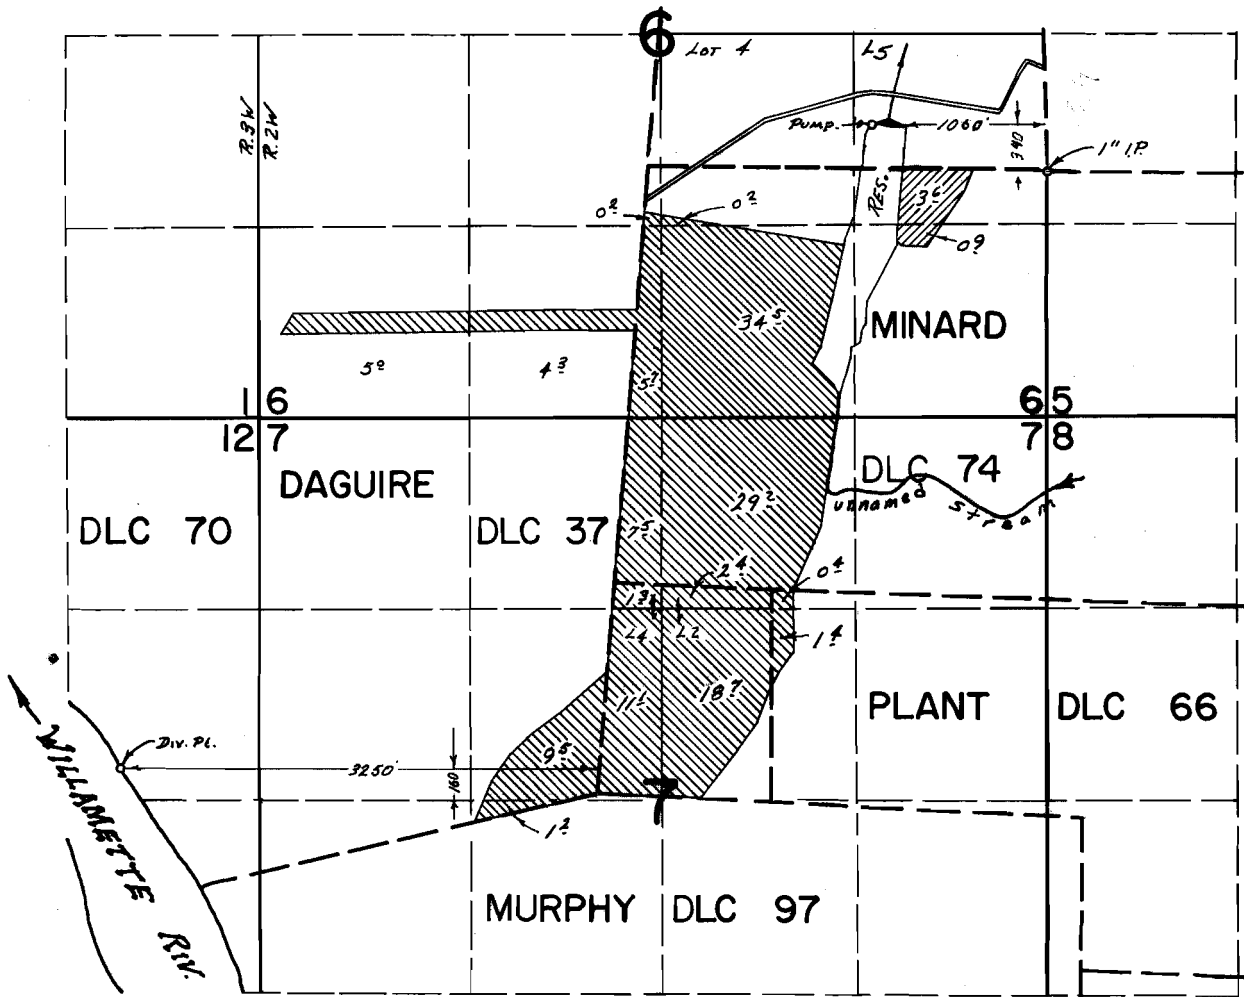

**FINAL PROOF SURVEY**  
UNDER

Transfer No. C-184  
Application No. 44511... Permit No. 33310...  
IN NAME OF

.....IRMA L. CALKINS.....

Surveyed JUNE 6, 1973, by R. G. MUCKEN