


# T. IN. R. 2E. W.M.

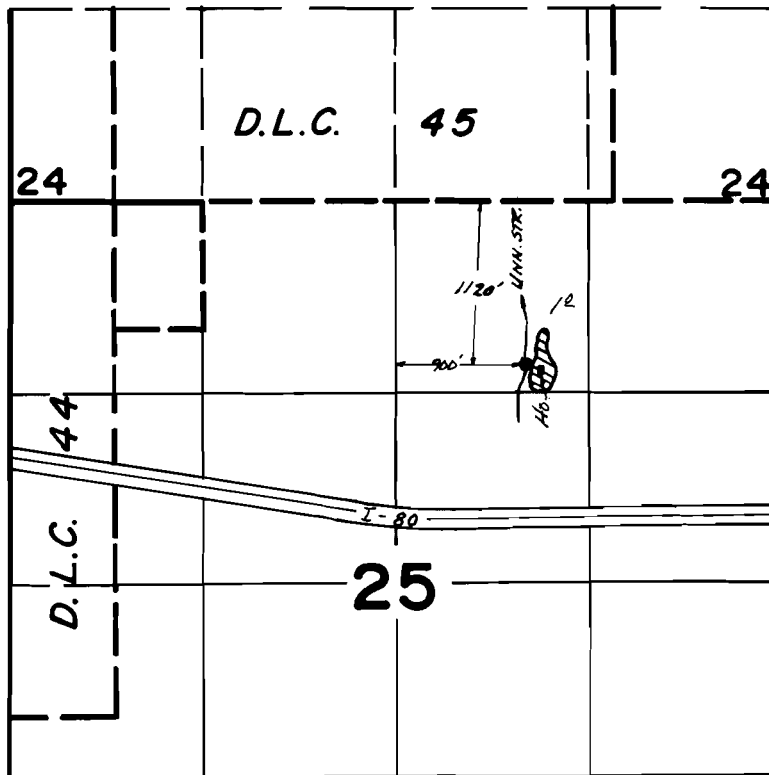

## FINAL PROOF SURVEY UNDER

Application No. 44080.. Permit No. 32993..  
IN NAME OF

BERT L. & LYNDA J. NESTELLE.....

Surveyed Oct. 26, 1978., by R.G. Mucken....