


T. 4N., R. 28E., W.M.

S1607
L1850
L7322

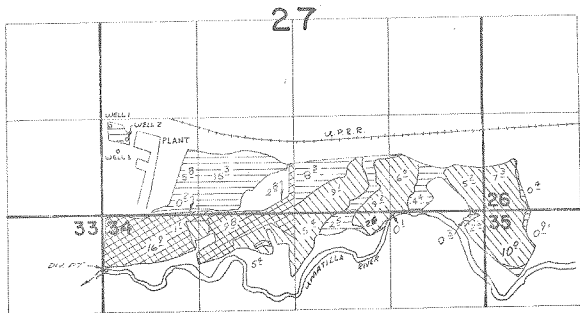

DIVERSION POINT LOCATED 150' S. & 50' E. FROM NW COR SEC. 34
WALL 1 LOCATED 1250' N & 130' E. FROM SW COR SEC. 27
WELL 2 LOCATED 1930' N & 360' E. FROM SW COR SEC. 27
WELL 3 LOCATED 880' N & 230' E. FROM SW COR SEC. 27



PER G-3853 PRIMARY



PER G-7077 PRIMARY



PER G-7077 SUPPLEMENTAL

FINAL PROOF SURVEY

UNDER

TRANSFER 3036

50554 & 37853

Application No. G-7168 Permit No. G-7077
IN NAME OF

J. R. SIMPLOT CO.

Surveyed 8-11, 1978, by R. BARWIN
10-26 1978 R. Barwin
9-27 1979 V. Church

R3-12
N2-1MM-138 V.C.