


T. 4N. R. 28E. W.M.

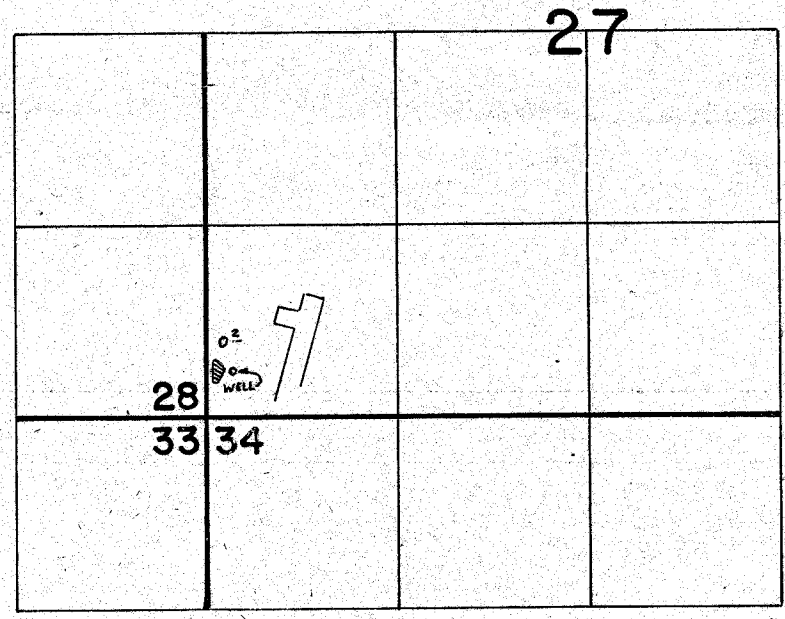

Well: 320' N & 200' E from SW cor Sec 27

FINAL PROOF SURVEY UNDER

Application No. G-2929 Permit No. G-2718
IN NAME OF

J. R. SIMPLOT CO.

Surveyed 6-18 1979 by V. CHURCH