


Basin 7

G-1180
51481
33559

T.6N.R.35E.W.M.

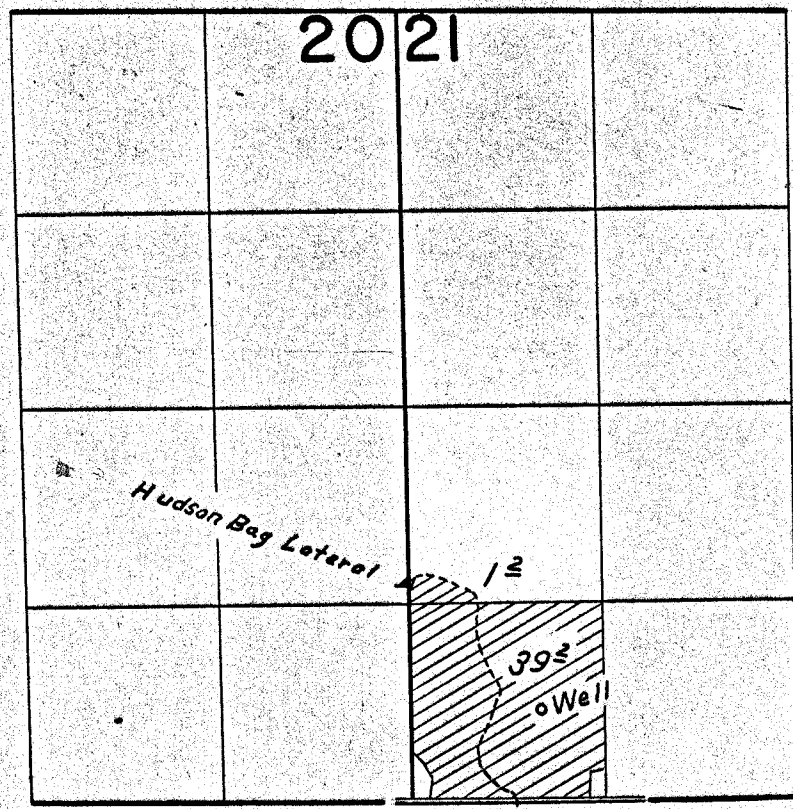

FINAL PROOF SURVEY UNDER

Application No. G-1181 Permit No. G-1180
IN NAME OF

ERMA L. ALEXANDER CASE & ROY W. ALEXANDER

Surveyed April 21, 1964, by R. Jackson.....

1964-A
CIC