


T. 9 & 10 S., R. 2 E., W. M.

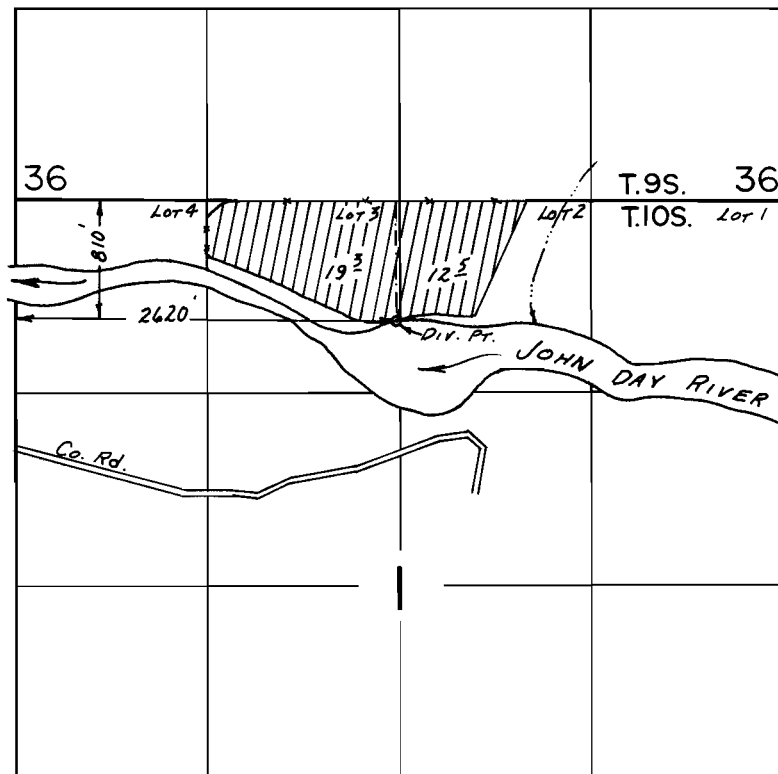

FINAL PROOF SURVEY
UNDER

Application No. 59263... Permit No. 44472.....
IN NAME OF

.....PAT BOHANNON.....

Surveyed JUNE 26, 1980., by S.C. BROWN.....