


Surveyed - Oct 30, 1925.

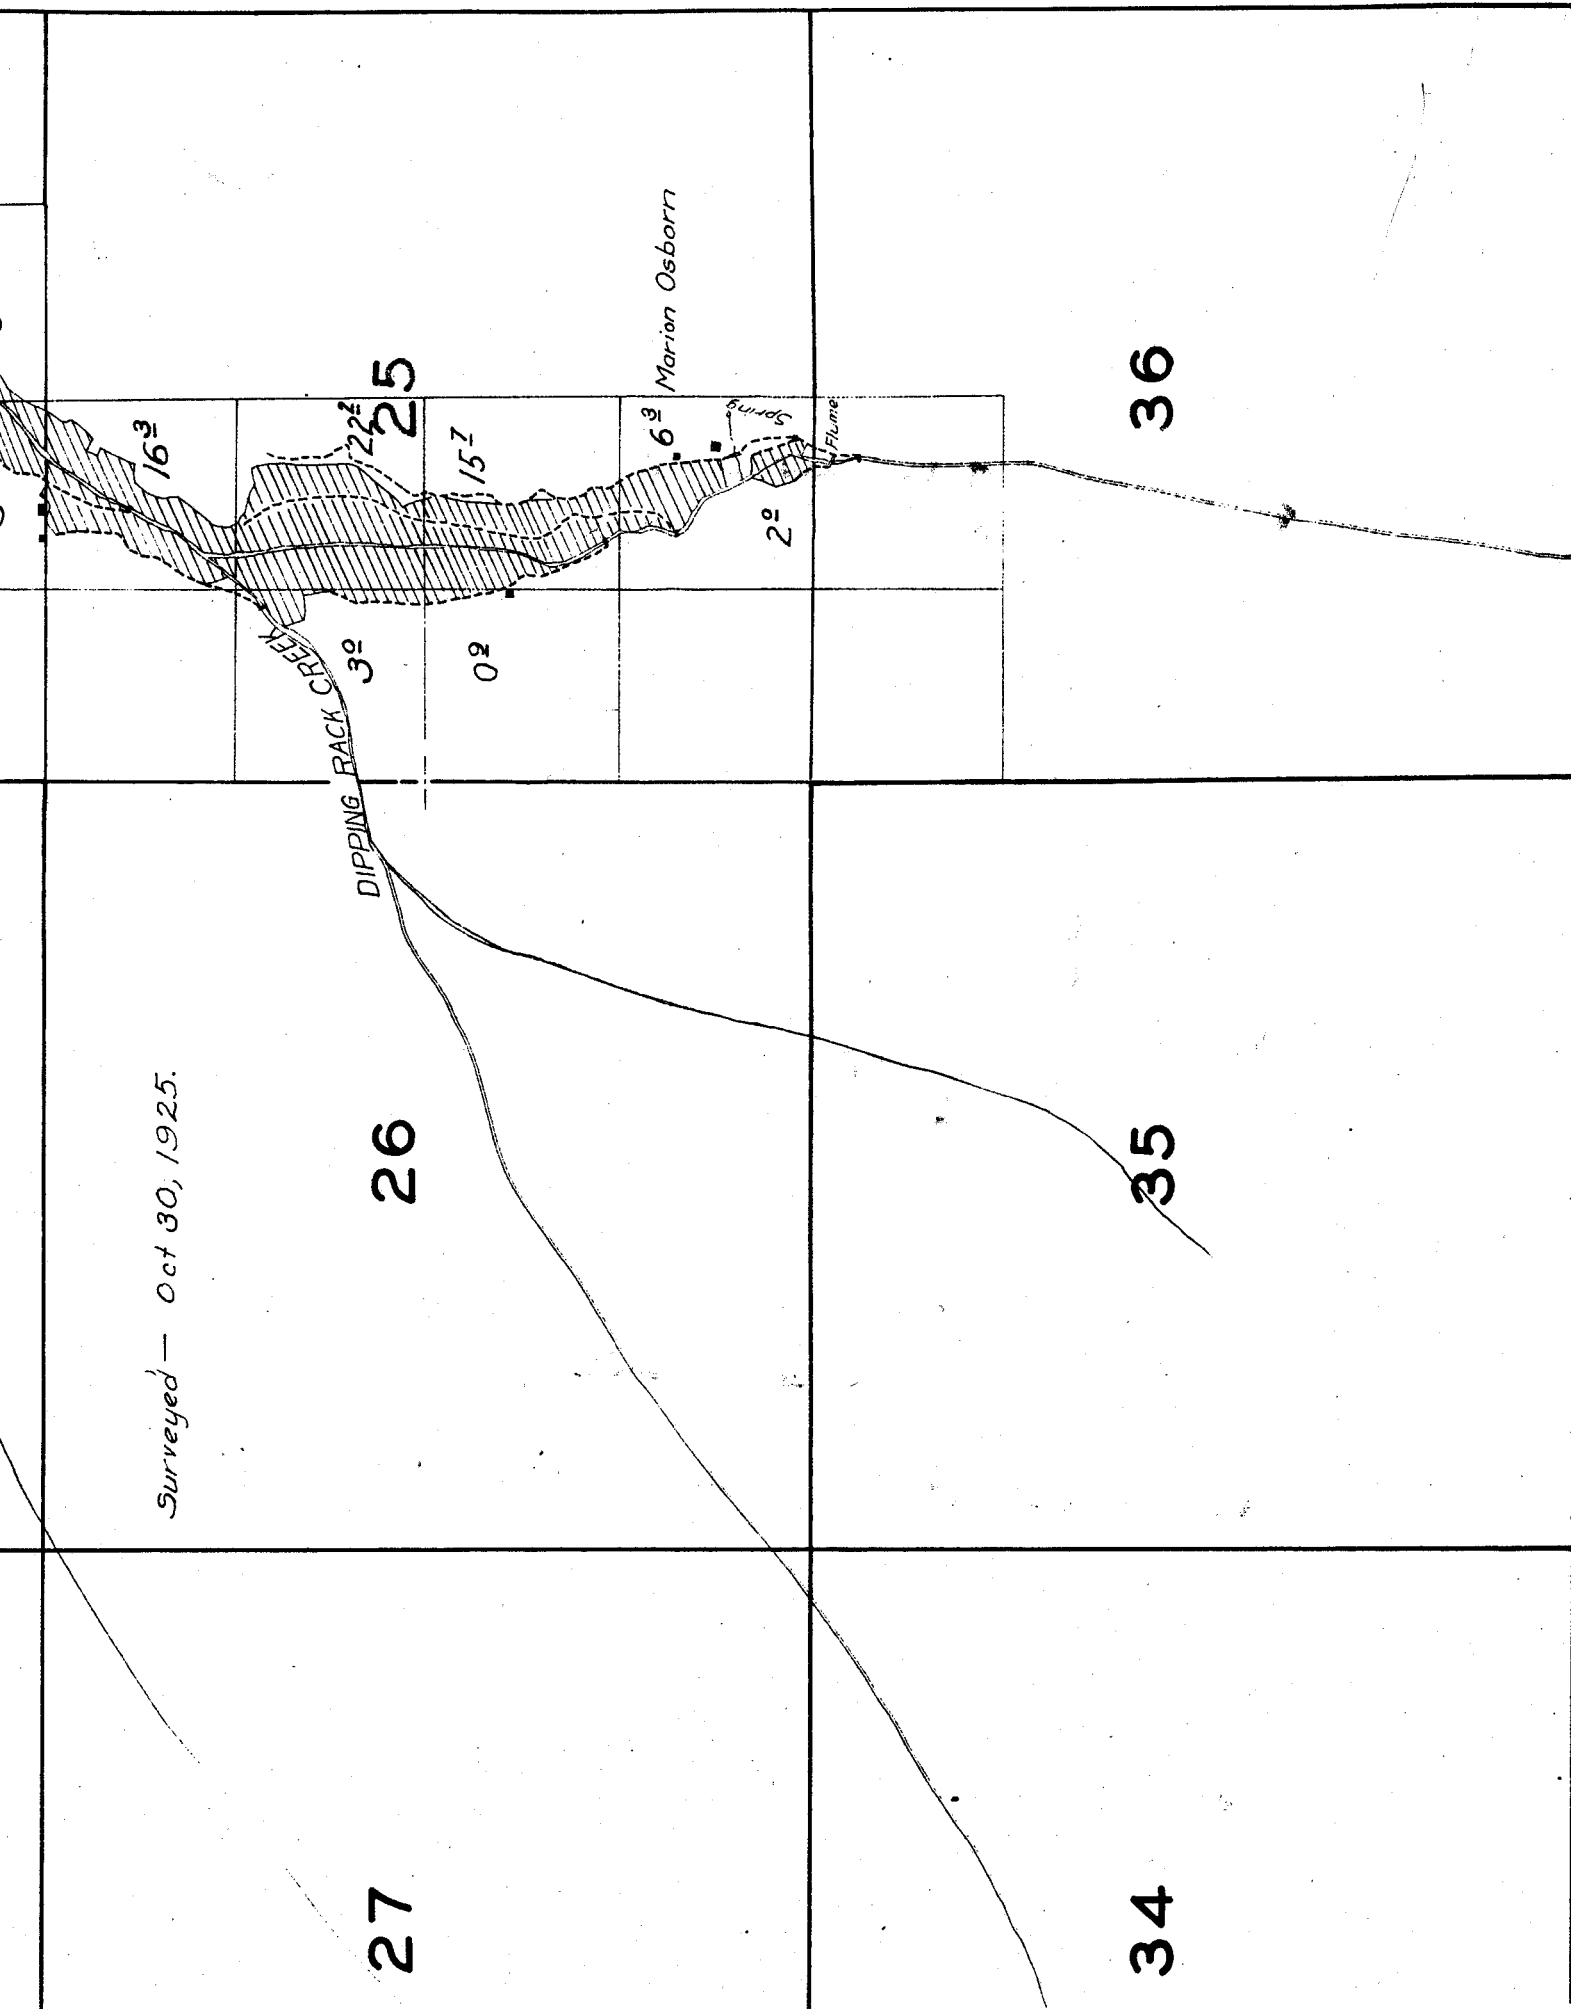

HORSESHOE
13 CREEK


14

15


24


23

22

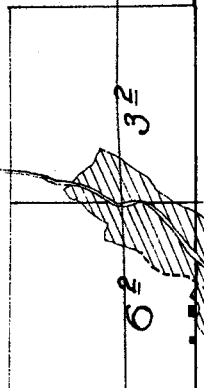


NOTE: Streams and vicinity of irrigated approximate location.

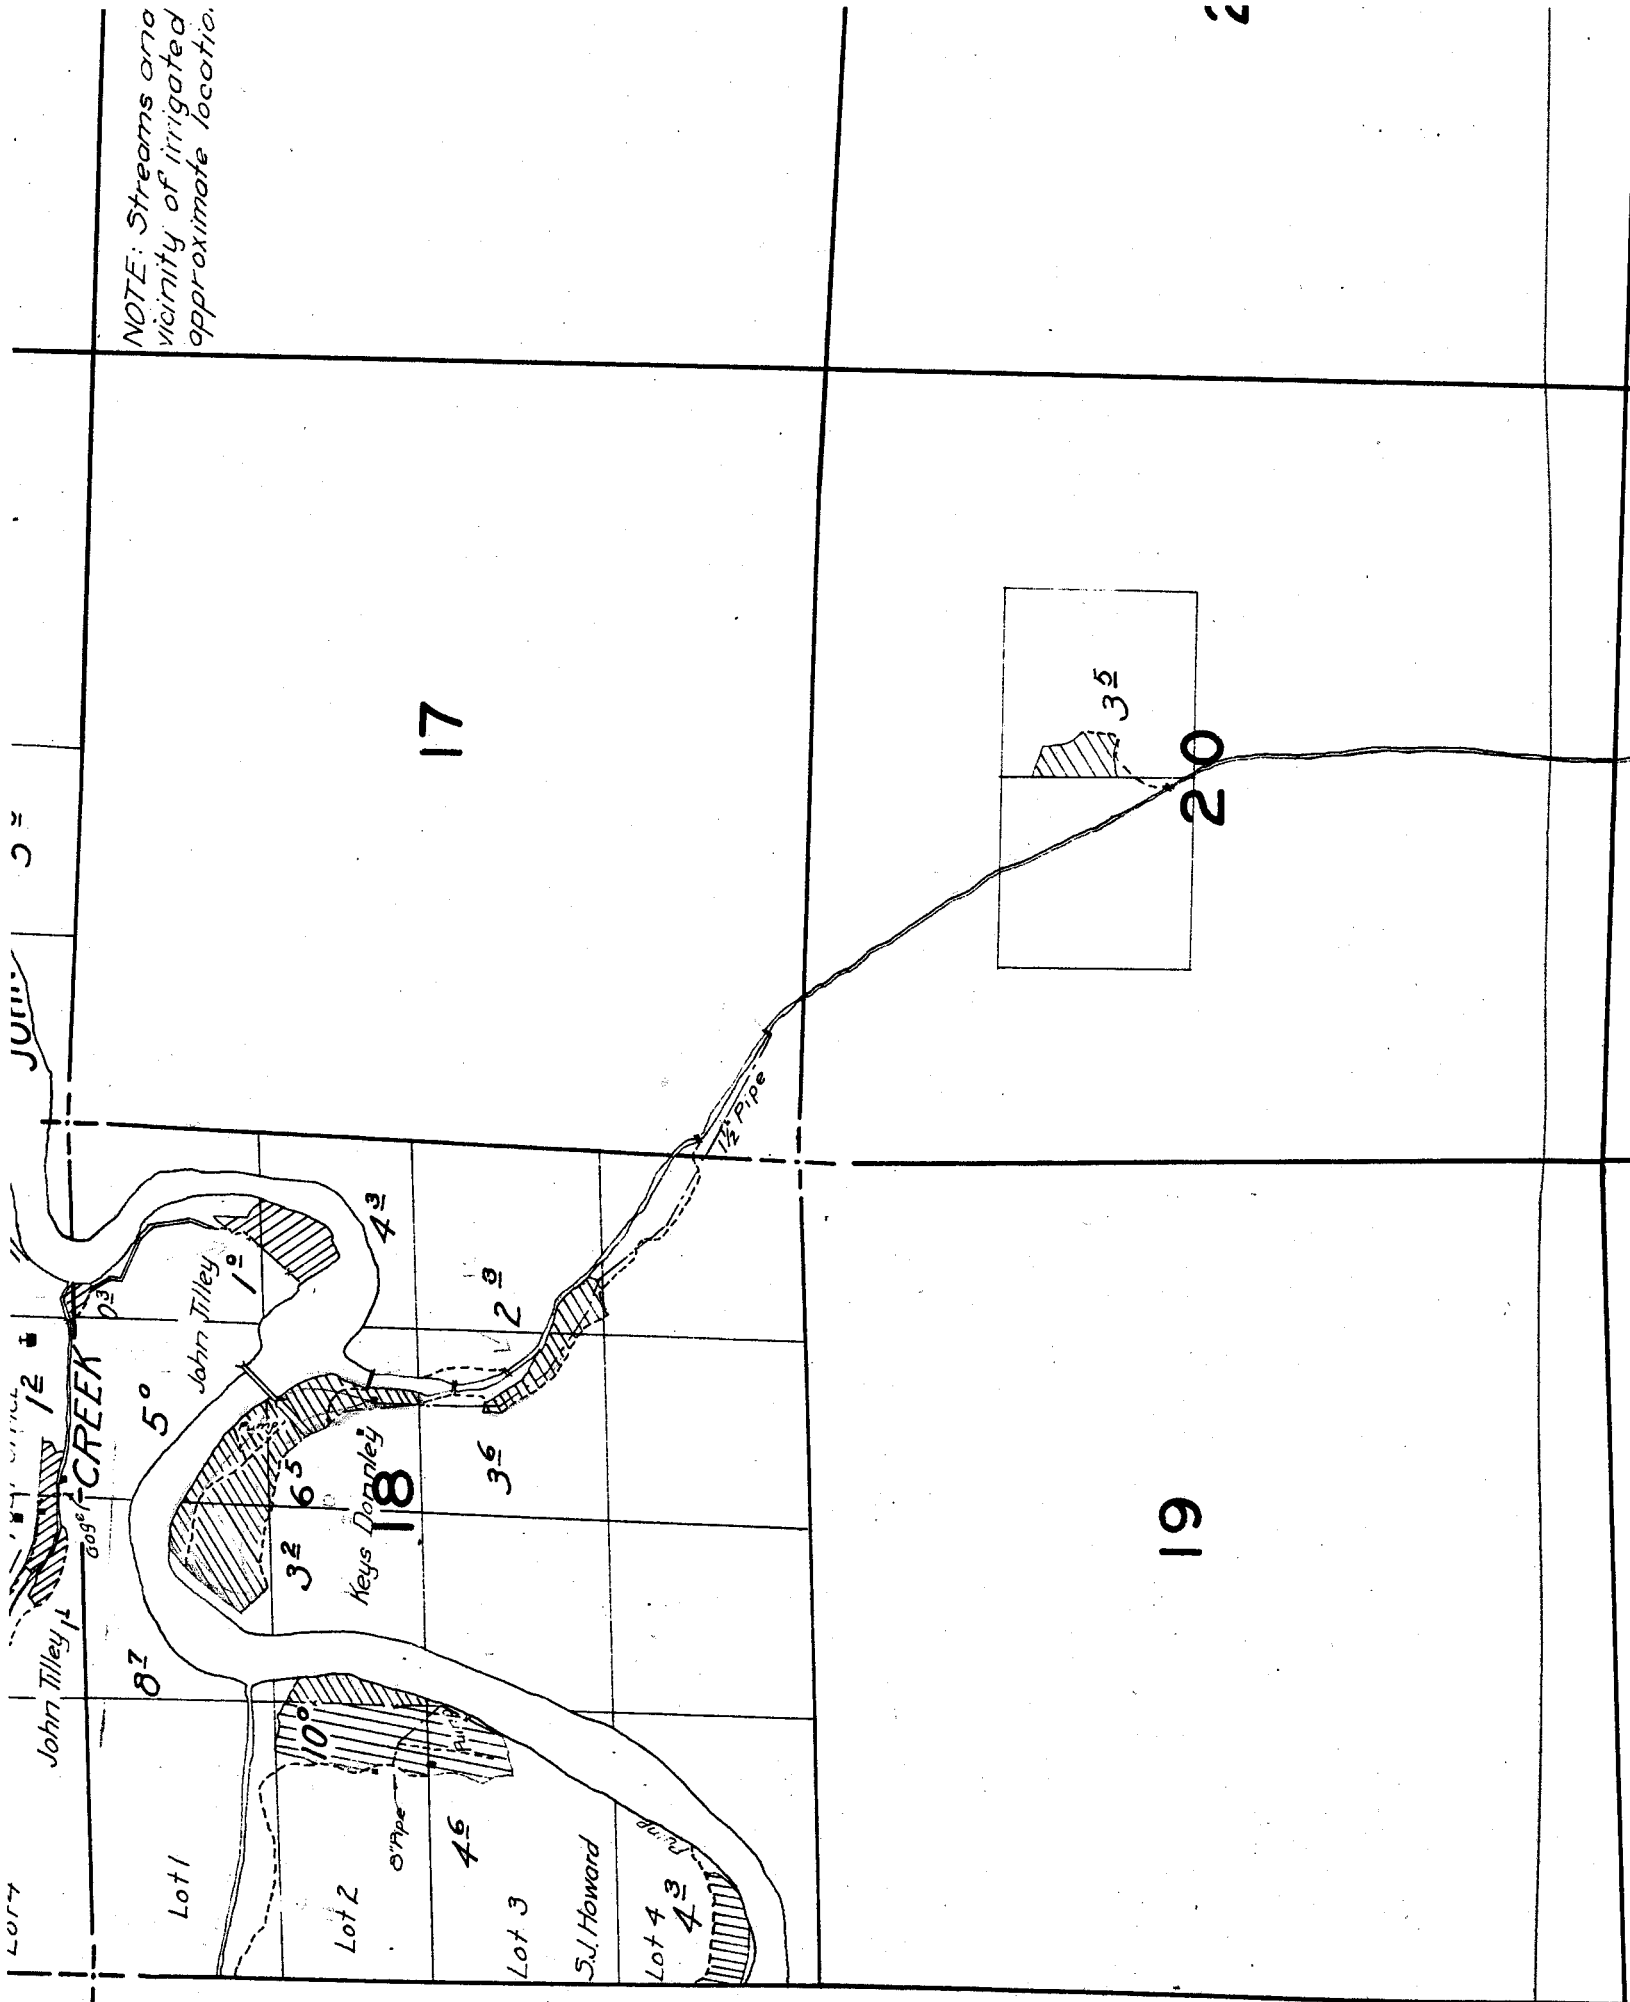

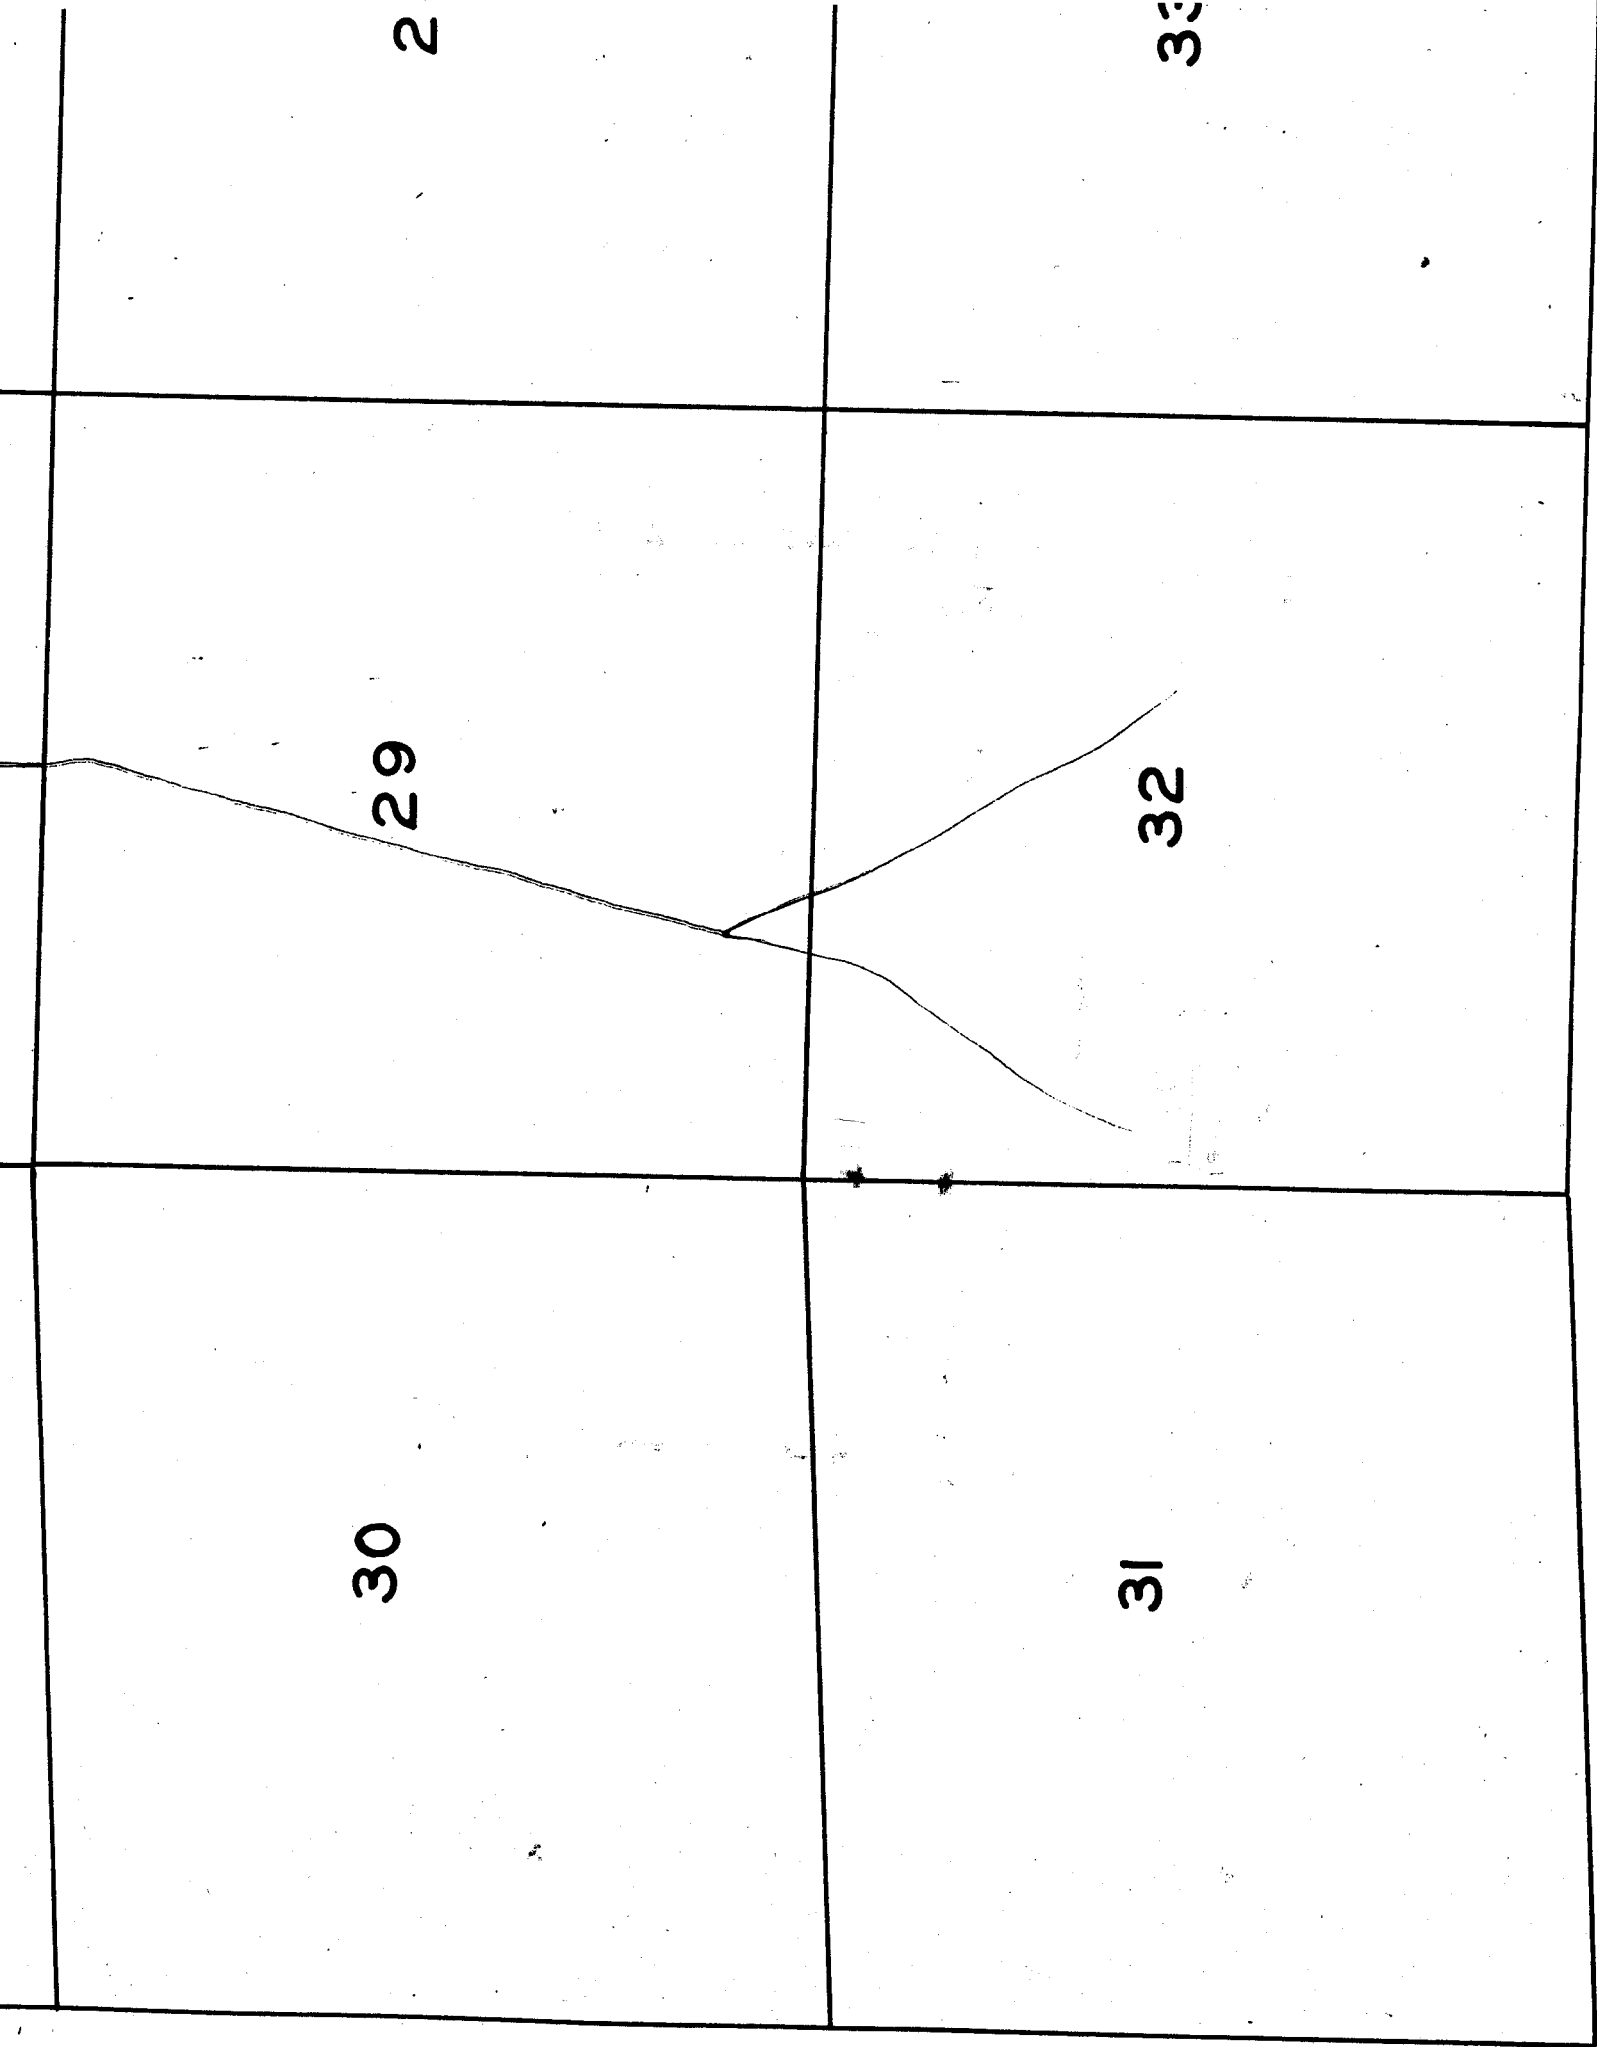

TOWNSHIP 9 S., RANGE 23 E.

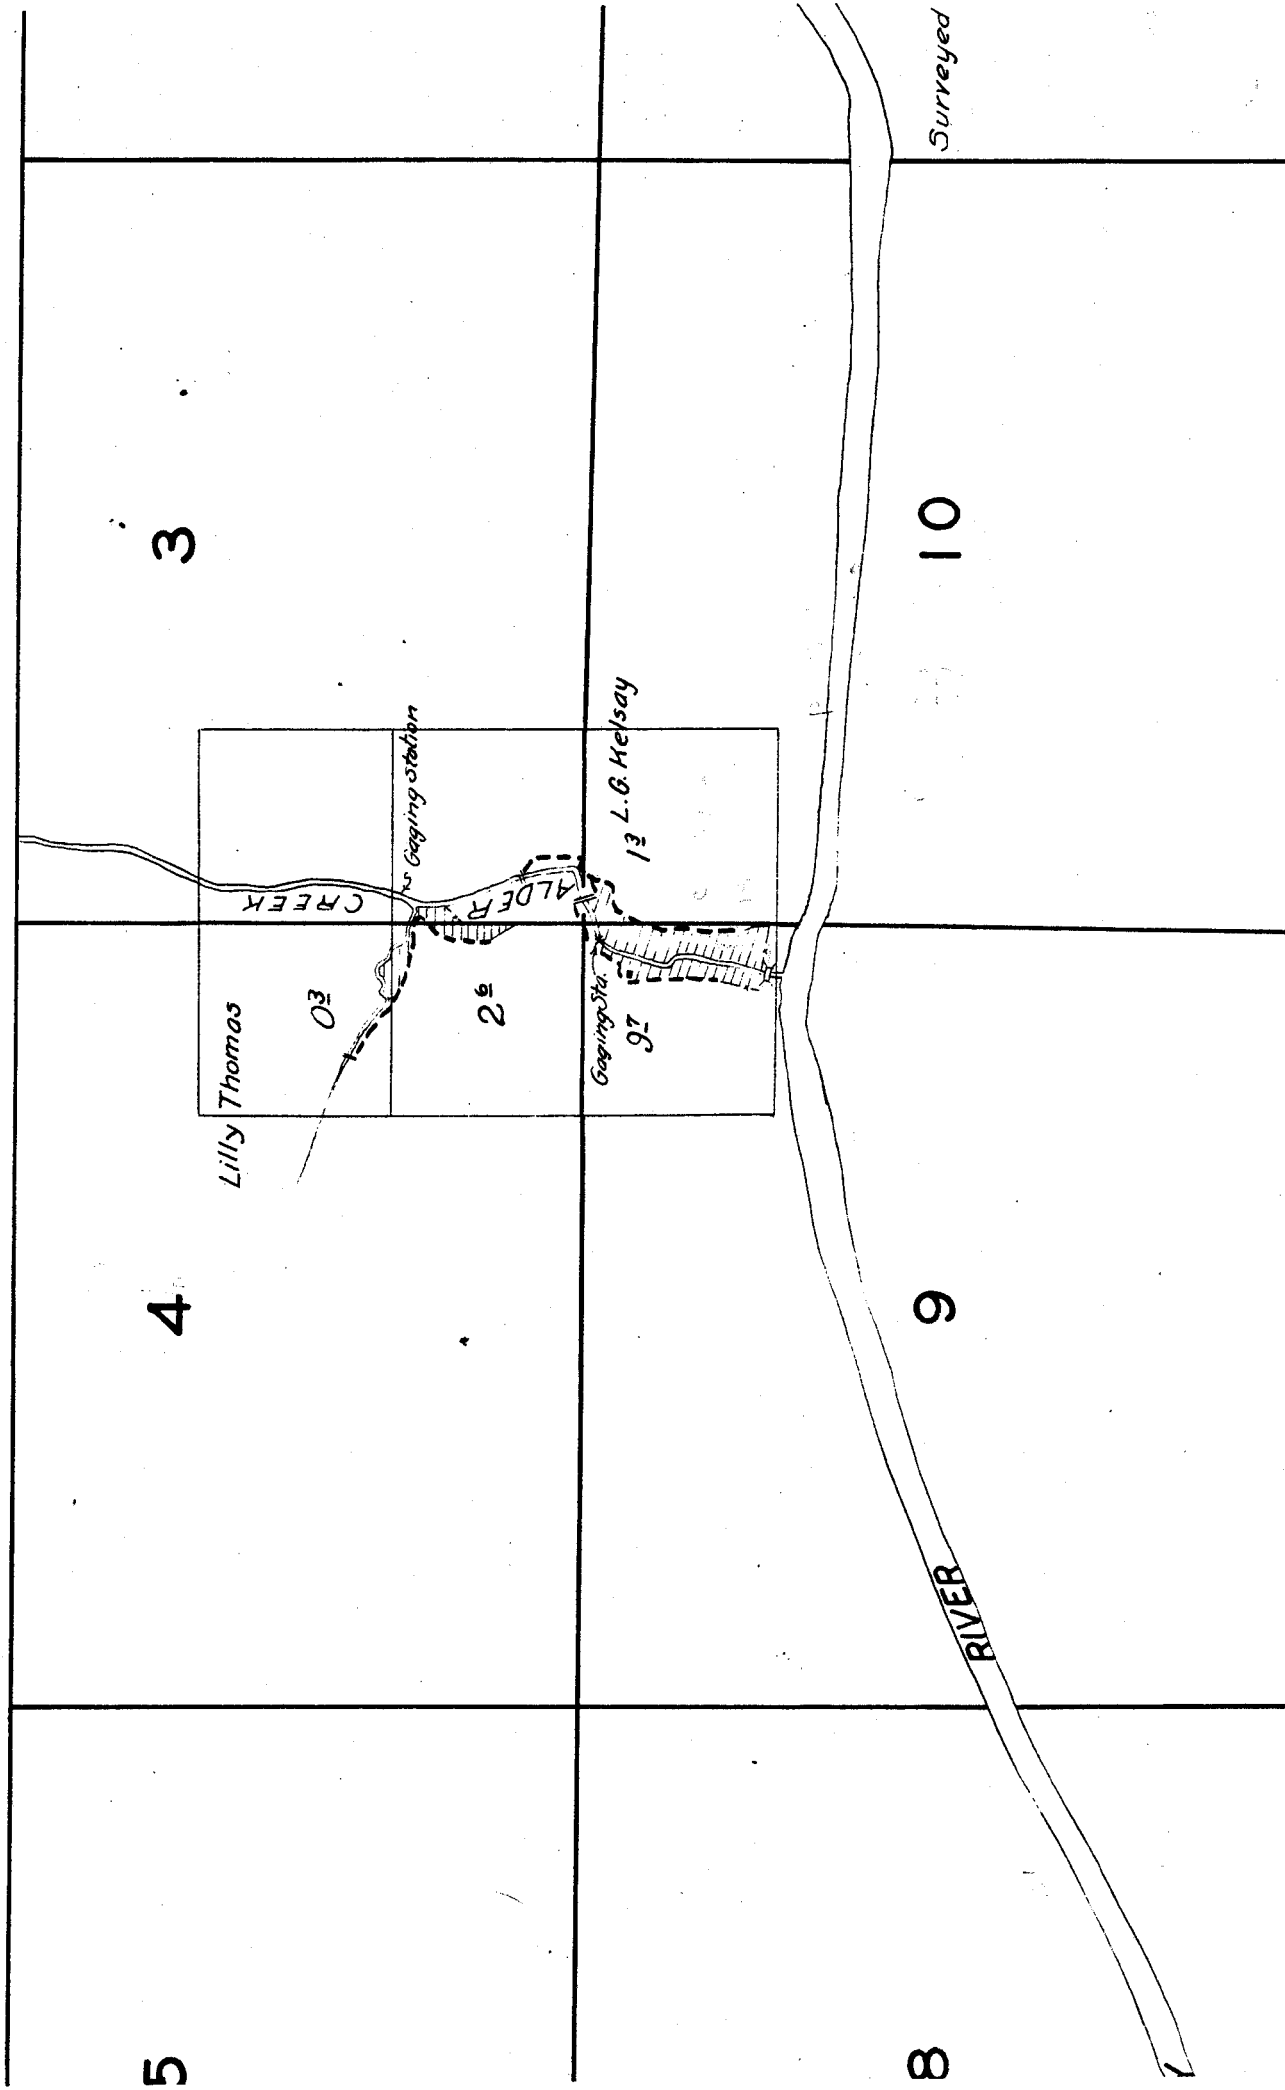

NOTE: Streams and river except in the vicinity of irrigated land, sketch in approximate location.

7

16

15

35

21

22

21

22

28

27

33

34

6

5

Surveyed Oct. 26, 22, 23, 1925.

7

8

Lot 1

Lot 2

Lot 3

Lot 4

M.J. Campbell

Ross Thomas

John Tilley

SERVICE CREEK
POST OFFICE

CREEK

JOHN

DAY

Lot 1

Lot 2

Lot 3

S.J. Howard

Lot 4

Keys Donnelly

John Tilley

8" Pipe

1 1/2" Pipe

18

17

2

1

1⁰

Rock

2⁰

J.E. Butler
Gage

0³

urveyed Nov. 7 1925.

11

12

0²

L.H. Wright

14

13

HORSESHOE
CREEK