


T. 4S., R. 4W., W.M.

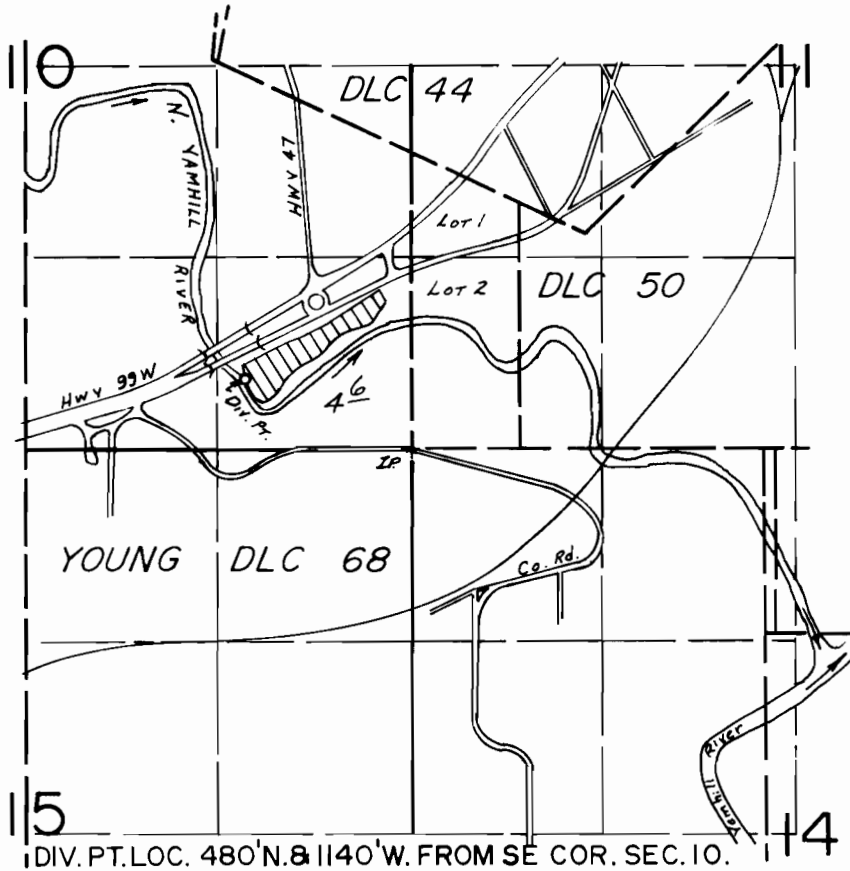

**FINAL PROOF SURVEY**  
UNDER

Application No. 52382 Permit No. 39407.....  
IN NAME OF

.....August Heidt.....

Surveyed JUNE 4 1980, by S.C. BROWN.....

*Handwritten initials*