


TOWNSHIPS 4,5 & 6 SOUTH, RANGE 3 WEST, W.M.

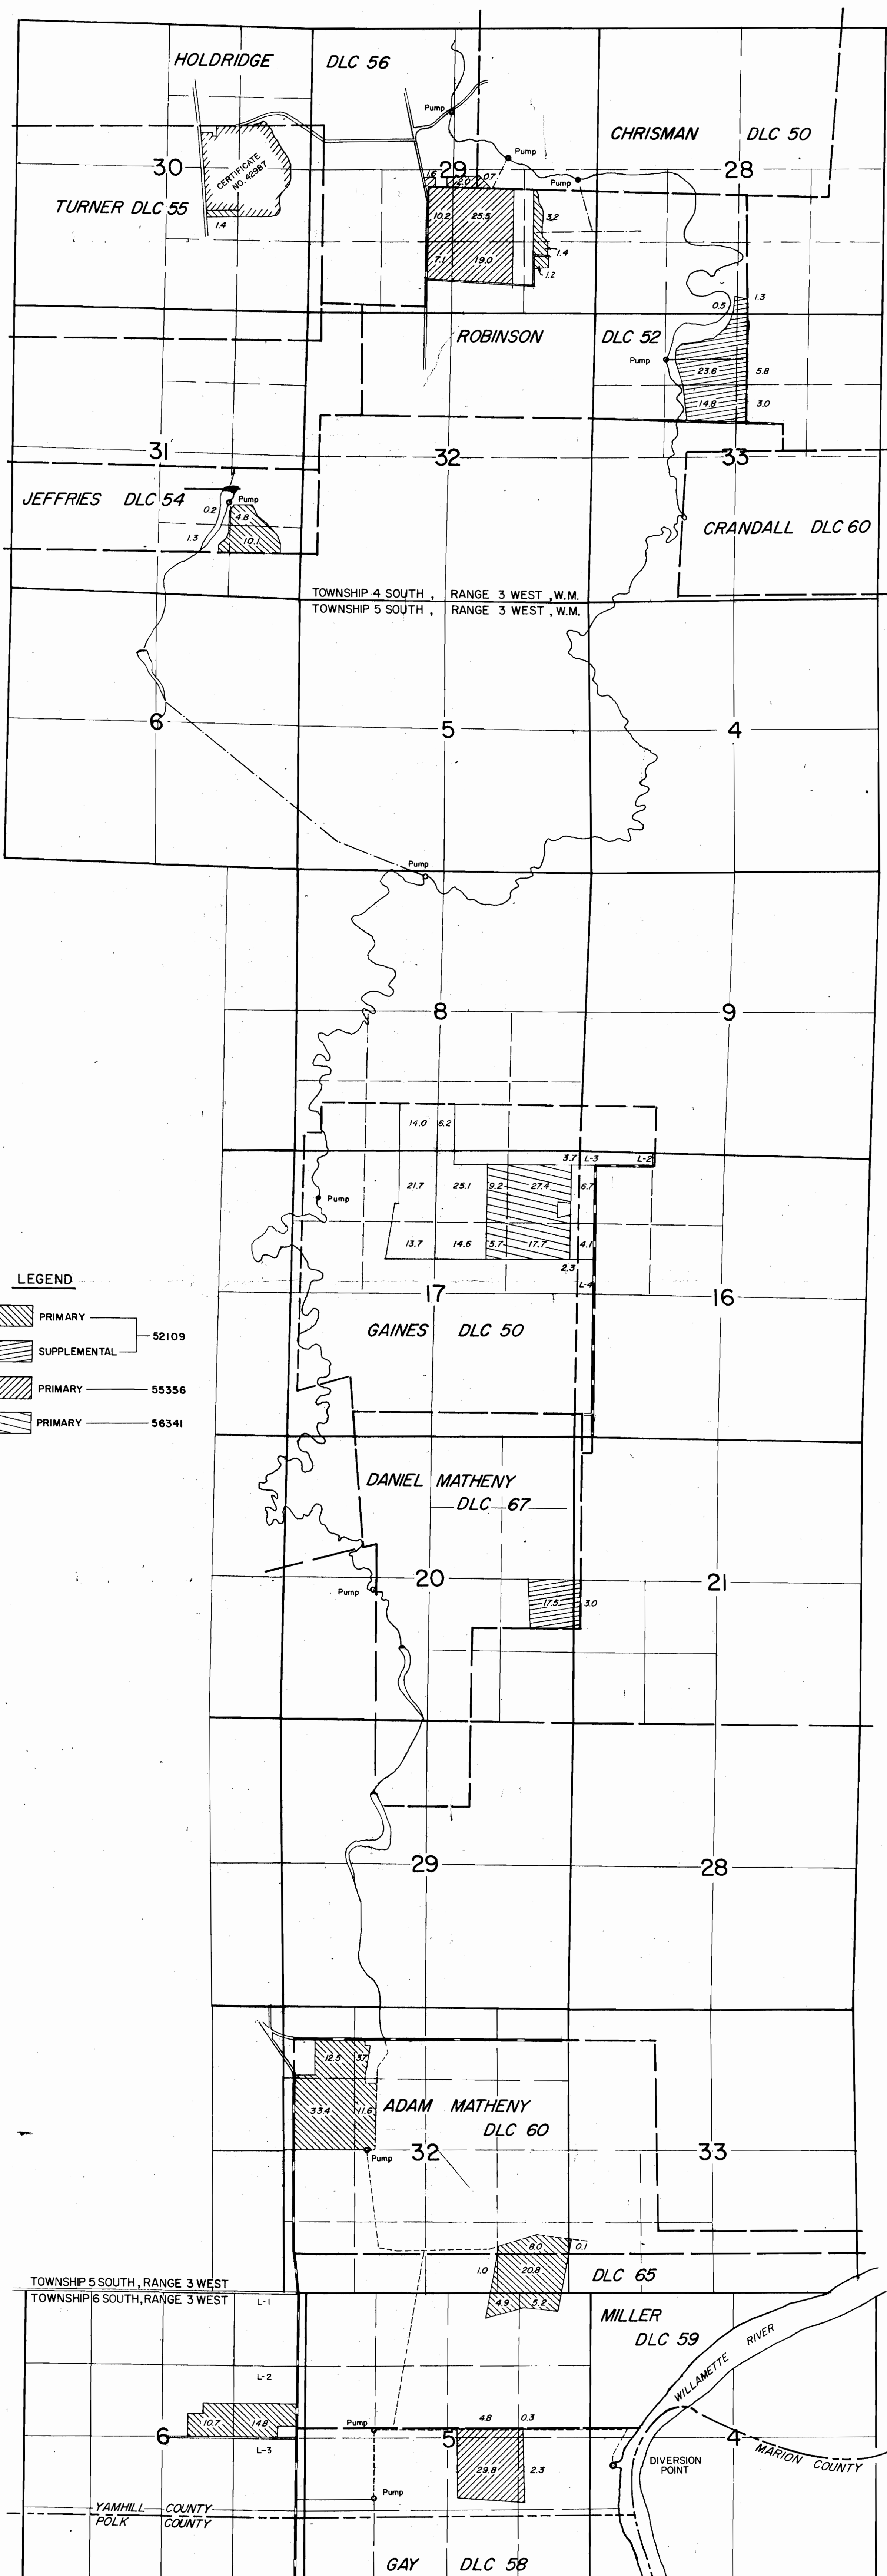

DIV. PT. LOCATED: 4700'N. and 1290'E. from S.E. cor. GAY DLC 58.

FINAL PROOF SURVEY

52109 39385  
 55356 41499  
 Application No. 56341 Permit No. 42316  
 IN NAME OF

PALMER CREEK WATER DISTRICT IMPROVEMENT COMPANY

Sep. 9, 1977 and  
 Mar. 6, 1978 L. H. Nunn  
 Surveyed May 8, 10, 11, 30, 1979 by S. C. Brown