


T4S. R1E. WM.

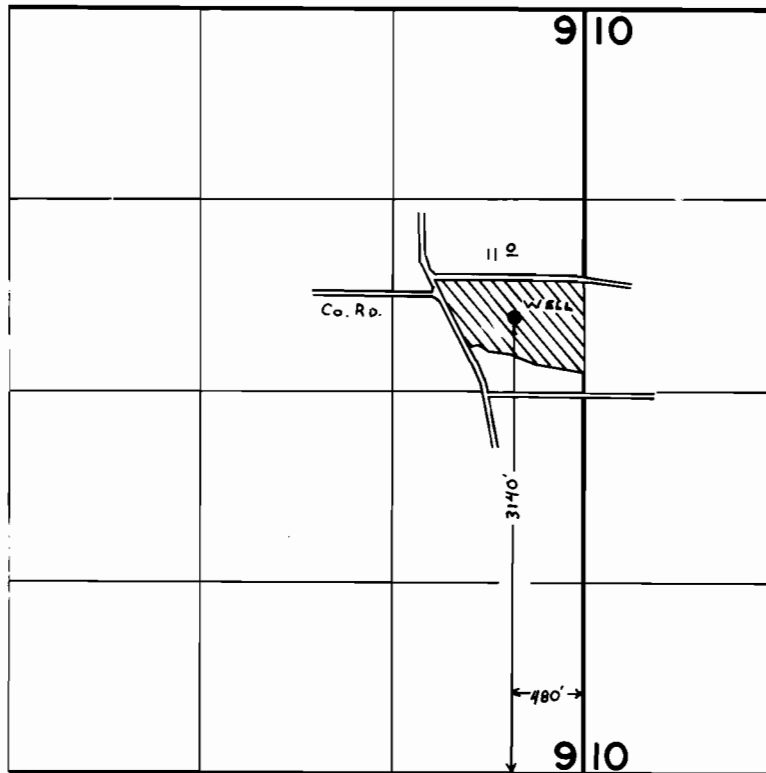

FINAL PROOF SURVEY UNDER

Application No. G-8223 Permit No. G-7572
IN NAME OF

William H. & Karl D. Schant

Surveyed AUG. 1 1978, by C. L. HUGHES