


T.40S., R.13W., W.M.

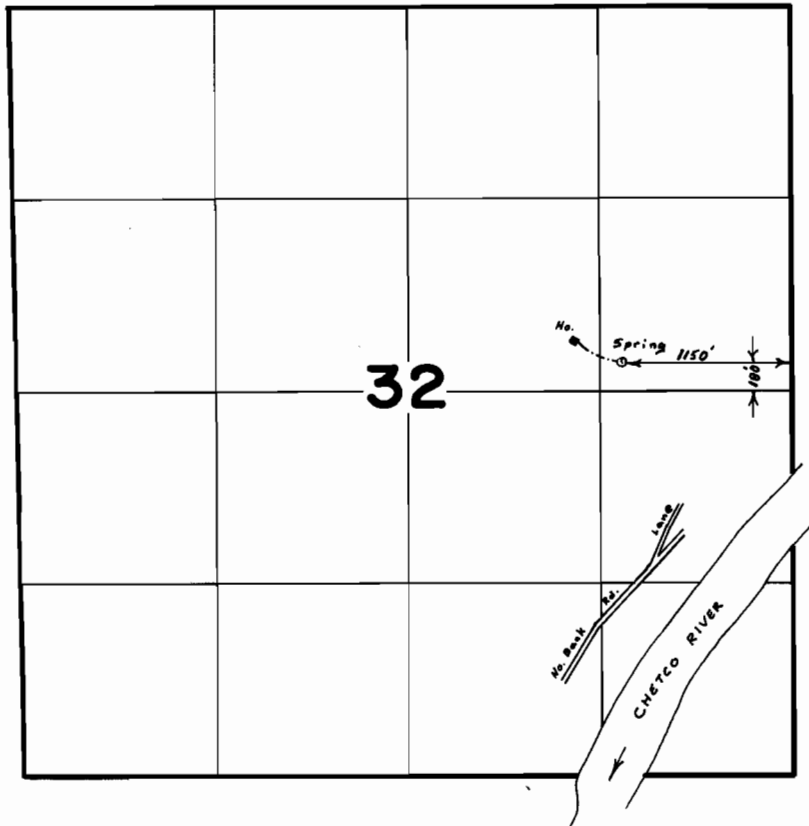

SCALE 4" = 1 mile

**FINAL PROOF SURVEY**  
UNDER

Application No. 55018.... Permit No. 41375....  
IN NAME OF

.....Rayburn & Jean Erwin.....

Surveyed August 15, 1979, by S. Donaldson..