


T. 29S., R. 7W., W.M.

SEC. 21

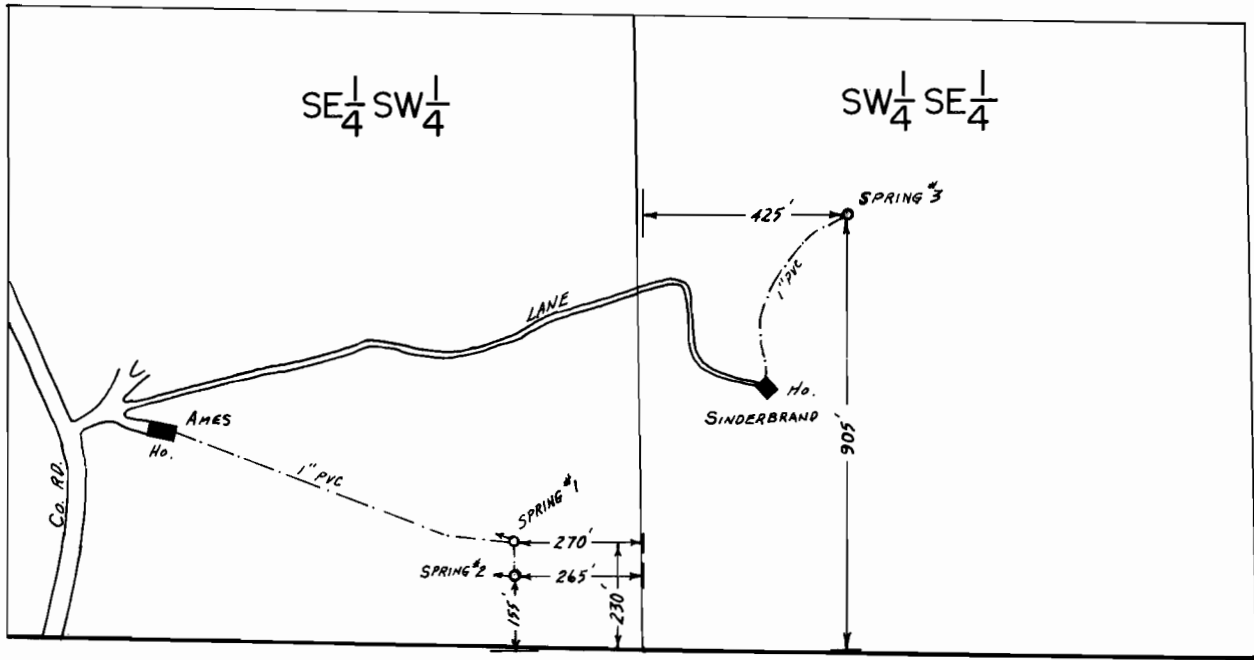

SCALE: 1" = 400'

FINAL PROOF SURVEY

UNDER

Application No. 50427... Permit No. 39120.....

IN NAME OF

SHARON SINDERBRAND & JACK AMES

Surveyed JUNE 5... 19.79, by J.S. DONALDSON

Doug. Co. 77-3-81
ZTS. BMB