


T. 30 S., R. 5 W., W.M.

Sec. 27

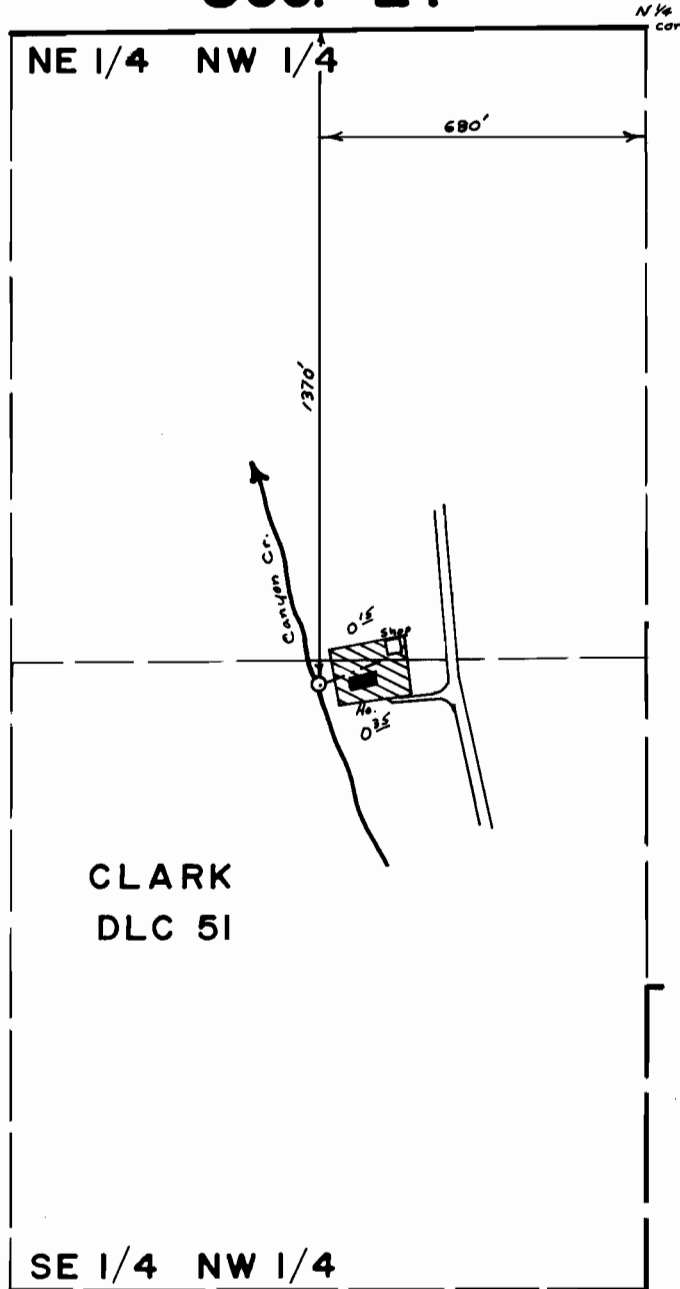

SCALE 1" = 400'

FINAL PROOF SURVEY
UNDER

Application No. 58364.. Permit No. 43983.
IN NAME OF

..... Daniel H. & Avis Jean Dick

Surveyed Oct. 25, 1979, by S. Donaldson.