

34605


RECEIVED

SEP 5 - 1979

WATER RESOURCES DEPT
SALEM, OREGON

Application No. 59299
Permit No. 44639

T.23S.R.5W.W.M.

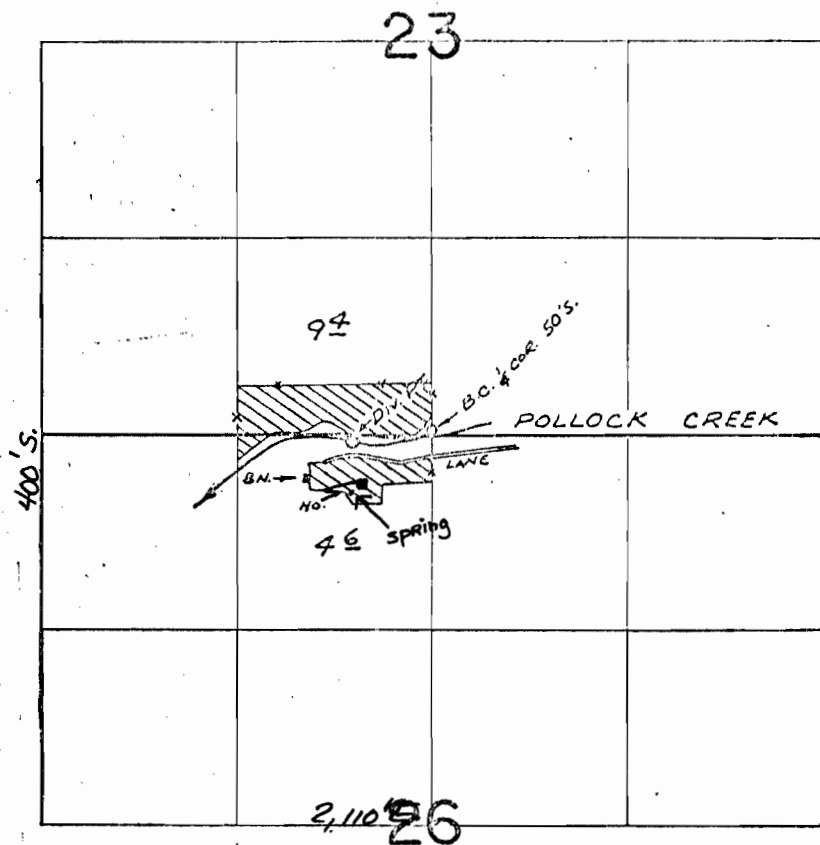

FINAL PROOF SURVEY
UNDER

Application No. 46314..... Permit No. 34605.....
IN NAME OF

GEORGE WHITE

Surveyed OCT. 16, 1974, by R. MUCKEN