


P- 4481
5785
51512

ALSO SEE MAP
WITH PROOF 47.

4/10 R 26 E N 7 M

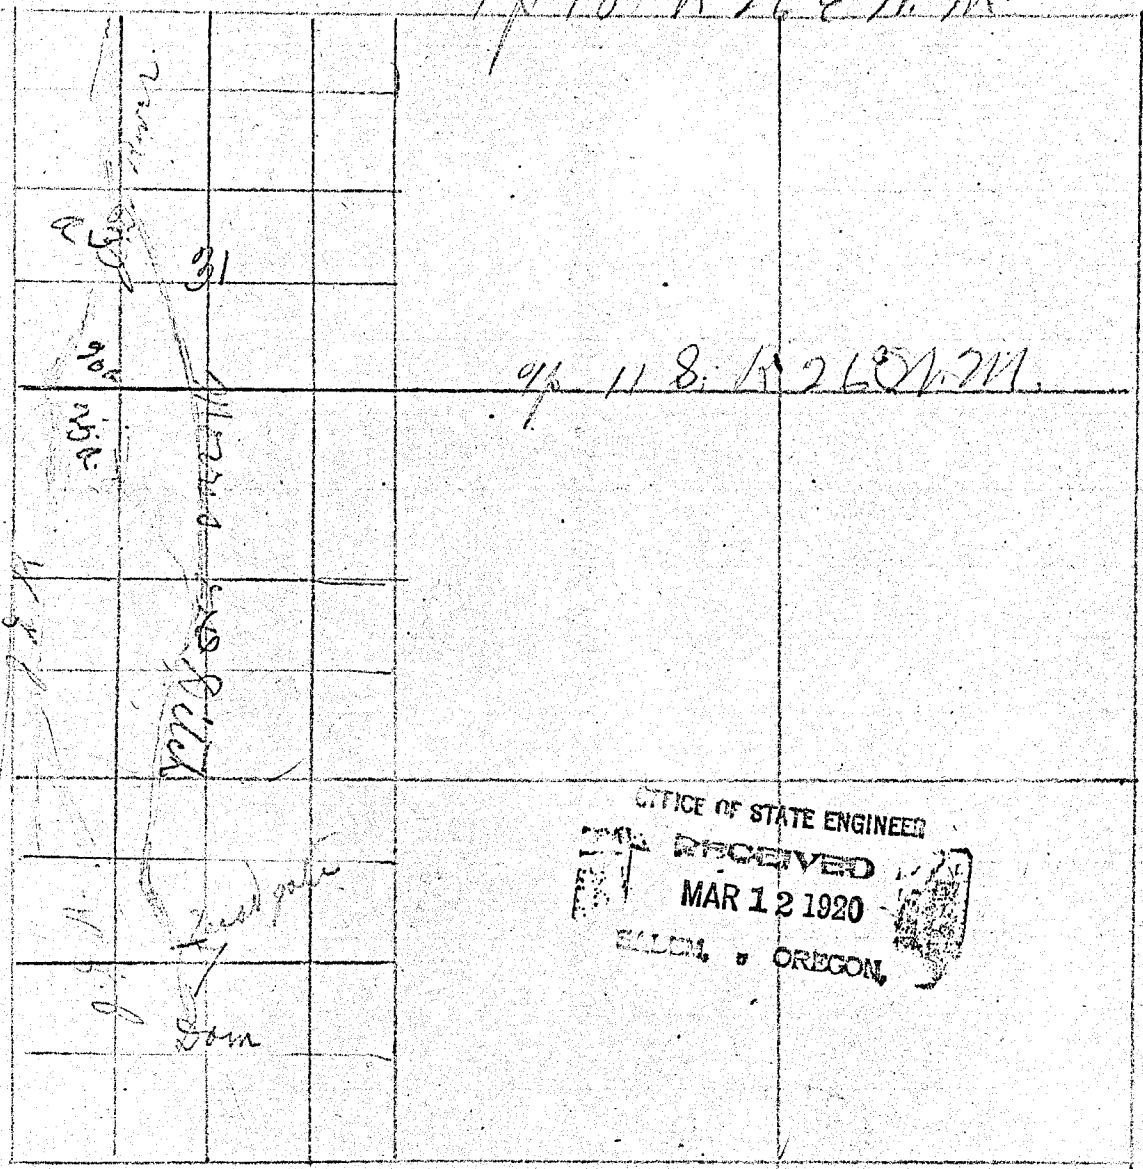

4/11 8: R 26 E N 7 M

OFFICE OF STATE ENGINEER
 RECEIVED
 MAR 12 1920
 SALEM, OREGON

31

Application No. 7137
Permit No. 4481