


P- 17226

17333
51514

10
T.11S.R. 26 E.W.M.

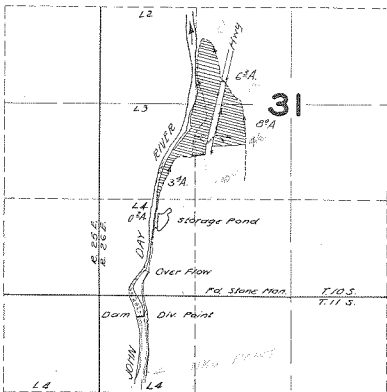

Vol 15 P 106
CH. 200

FINAL PROOF SURVEY
UNDER

Application No. **21848**. Permit No. **17226**
IN NAME OF

W. J. FOREE

Surveyed OCT. 30. 1949., by **H.L. COFFMAN**.