


T. 35 S., R. 4 W., W.M.

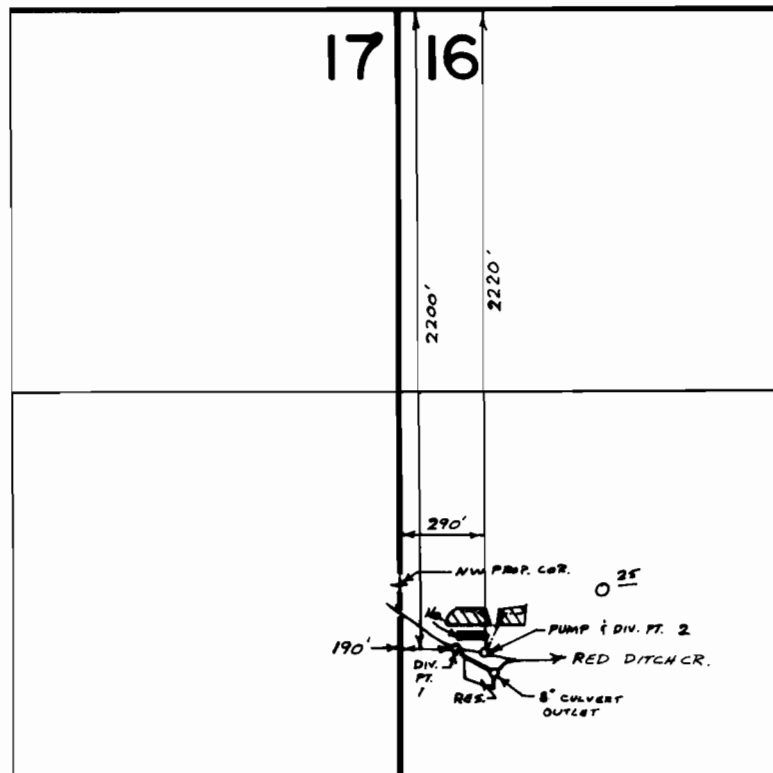

SCALE: 1" = 660'

FINAL PROOF SURVEY
UNDER

R-49149

R-5981

Application No. 49150 Permit No. 36852
IN NAME OF

MARVIN C. & MILDRED L. JESSEE

Surveyed AUG. 2, 1978, by BRUCE R. SUND