


T16S. R6W. WM.

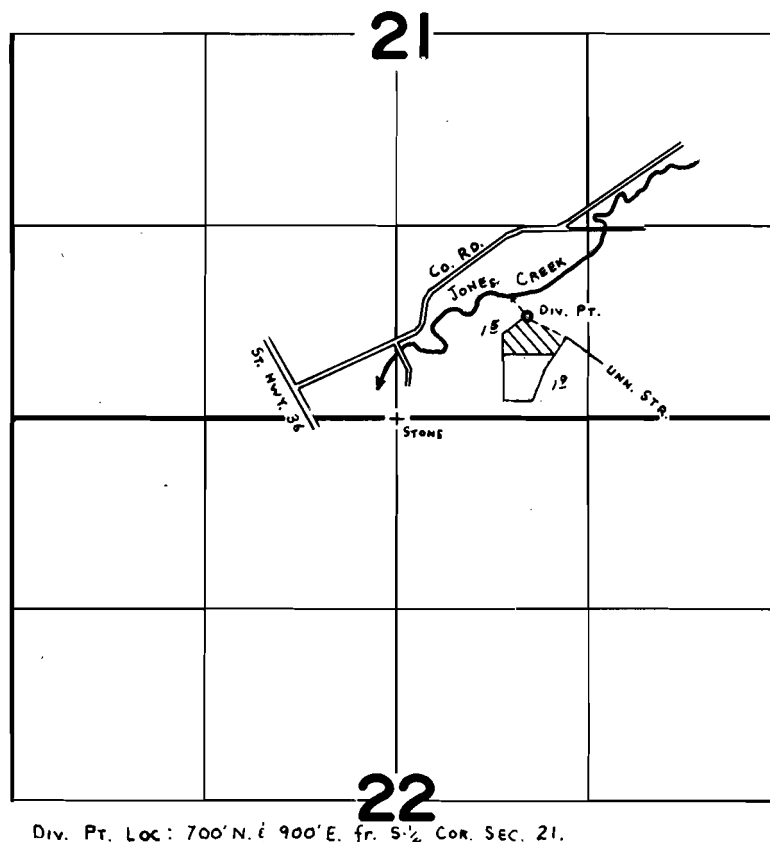

Div. Pt. Loc: 700' N. & 900' E. fr. S $\frac{1}{4}$ Cor. Sec. 21.

FINAL PROOF SURVEY
UNDER

Application No. 53257 Permit No. 39522
IN NAME OF

KERRY B. WALLACE

Surveyed JUNE 14 1978, by C. L. HUGHES