


T. 2N., R. 32 & 33E., W.M.



DIV. PT. LOCATED 10' N. & 1820' W. FROM E 1/4 COR. SEC 1

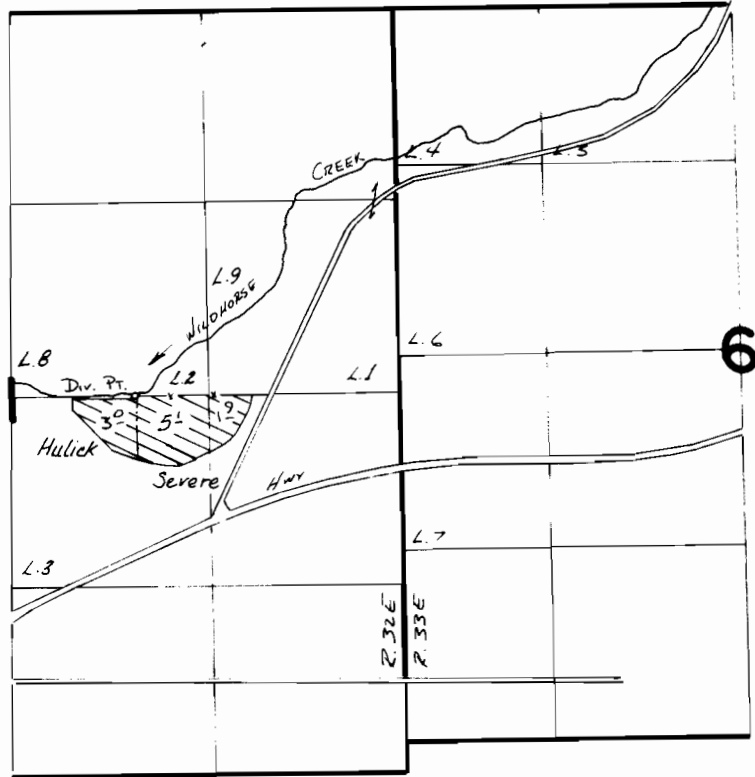

SCALE: 1" = 1320'

FINAL PROOF SURVEY
UNDER

Application No. **8740**... Permit No. **5705**....
IN NAME OF

DELORES SEVERE & DON HULICK

Surveyed Jan. 21, 1986., by V. L. Church