


# T.18S.R.5W.W.M.

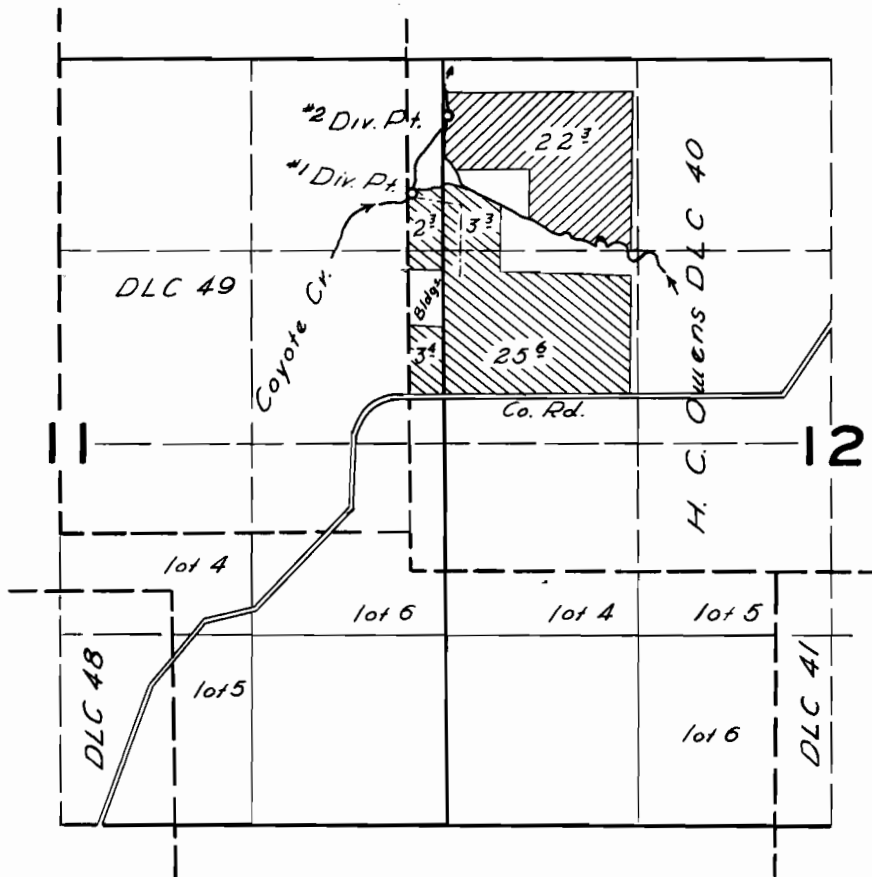

## FINAL PROOF SURVEY

UNDER

26294

20639



Application No. 26293 Permit No. 20638



IN NAME OF

Surveyed 6 May 1957, by *[Signature]*